

COMMUNITY COLLEGE OF ALLEGHENY COUNTY  
PURCHASING DEPARTMENT  
800 ALLEGHENY AVENUE, PITTSBURGH, PA 15233

**ADDENDUM 3**  
**BID PROPOSAL NO. 1148**  
**BIOLOGY LAB RENOVATIONS – BOYCE CAMPUS**  
**GENERAL, ELECTRICAL, HVAC, AND PLUMBING**  
**MAY 13, 2026**

The following additional information is hereby made a part of this bid:

\*\*\*\*\*

**The bid due date has been further extended to Monday, May 18, 2026, at 2:00 p.m.**

See the accompanying spreadsheet with various questions and answers.

Also attached are standard CCAC Telecom Specifications.

Updated drawings are attached: E001, ED101, ED103, E101, E201, E501, E602, FA101

**End of Addendum 3**

\*\*\*\*\*

Sign addendum and return to the College with your response.

\_\_\_\_\_  
Company Name

\_\_\_\_\_  
Bidder's Signature

## CCAC Telecom Specs

### Data Drop Placement

- Unless otherwise noted, 18" AFF.
- Data Drop in Ceiling (WAP): (2) cables, 10' coil in ceiling each.
- Data Drop in Ceiling (Surveillance Camera): 10' coil in ceiling.
- Data Drop in Ceiling (Other): 10' coil in ceiling.
- Data Drop in Wall (Phone Only): 39.5" AFF.
- All others (digital signage, etc.) are non-standard and would need to be discussed for placement.

### Specifications



1. All cabling and connectivity solutions shall be made of solid copper cable, minimum gauge 23 AWG, minimum 500 MHz rated, plenum-rated (and/or outdoor rated when the cable is in exterior location), category 6 (or category 6A, *depending on location*).
  - a. The cabling manufacturer and model must be one of the following below or an approved alternate via submittal if it is not on the list.
    - i. Hubbell – NextSpeed
    - ii. General – GenSPEED
    - iii. Panduit – Pan-Net
    - iv. Commscope- Netconnect
    - v. Berk-tek-LANmark
    - vi. BlackBox- GigaTrue
    - vii. Vertical Cable
    - viii. Paige – GameChanger Cable

#### CCAC Cable Color Standards



- Blue for data and VoIP
  - Black for surveillance
  - White for analog dial tone
  - Yellow for Access Control
- b. No drop length shall exceed 90 meters (295 ft.) from the patch panel to the faceplate. If a cable run is required to be over 90 meters, then written approval must be obtained from the CCAC ITS Department, and the use of Paige GameChanger Cable is required.
  - c. Cabling shall be run in a continuous manner with no splices. (The only exception would be an Ethernet surge protector for outdoor runs, where specified)
  - d. The cable manufacturer's bend radius is to be strictly followed.
  - e. Cable pathways shall maintain the following clearances from sources of EMI:
    - i. Forty-six (46 in.) from motors and transformers.
    - ii. One foot (1 ft.) from conduits and cables used for electrical power.
    - iii. Three inches (3 in.) from fluorescent lighting.
  - f. Cat6 cable shall not be pulled in excess of 25 lbs.


- g. The use of exposed surface raceways will not be permitted. Where building construction must be cut to conceal new conduit and wiring, the contractor shall patch and finish disturbed areas to match adjacent surfaces
  - h. Direct runs (diagonal) are not acceptable.
  - i. If existing cabling needs to be replaced, all old cabling must be fully removed properly.
  - j. Any old cables approved by CCAC to be left need to be clearly marked dead on both ends with machine-printed labels.
  - k. Terminations should be completed in accordance with the T-568B standard.
2. Jacks: Jacks at faceplates to match cable color (Blue for data and VoIP; white for analog voice, and black for cameras).
  3. Patch Panels: Keystone compliant with the corresponding manufacturer's inserts for terminations
  4. Faceplates: Keystone compliant with corresponding manufacturer inserts for terminations. Field coordinated for color to match the decor.
  5. Male RJ-45 terminations are only allowed for surveillance cameras, Enlighted gateways, and inside CCAC approved IoT devices or cabinets.
  6. All exterior connections must use dielectric grease and proper weather sealing per the manufacturer's specifications and instructions.
  7. Racks: Hubbell NextFrame Rack w/6" Z Channels Vertical Managers (CS1976).
  8. Modular Patch Cords: Two cords are provided for every drop installed. One 1-foot cable and 1 10ft cable matching installed category cabling in both color and specification.
  9. All cabling shall be installed and supported as follows
    - a. Support cat6 cables w/ appropriately sized j-hooks, located on 48" on center
    - b. Hooks shall support no more than 50 cables
    - c. Cables shall not be attached to the suspended ceiling systems or duct work. All exposed cable shall be run in conduit, existing cable tray, or secured to cable tray utilizing j-hooks.
    - d. Velcro is the only acceptable cable tie-wrap
  10. All cabling is to be certified with a currently calibrated Fluke CableAnalyzer or equivalent testing unit to verify compliance. Contractor shall provide the owner's representative with complete test results and a 20-year cable warranty.
  11. All national, state, and local codes shall be strictly adhered to. Where more than one code applies, the most stringent shall be adhered to. All conduit sleeves and penetrations through fire-rated partitions shall be fire-stopped.
  12. All patch panels, terminations, shelves, and enclosures will be labeled in a professional manner in accordance with the following CCAC Label Schema. Labels must be preprinted and match the existing design within the data closets. All patch panel manufacturer labels must be visible and not covered.

### Labeling for all patch panels

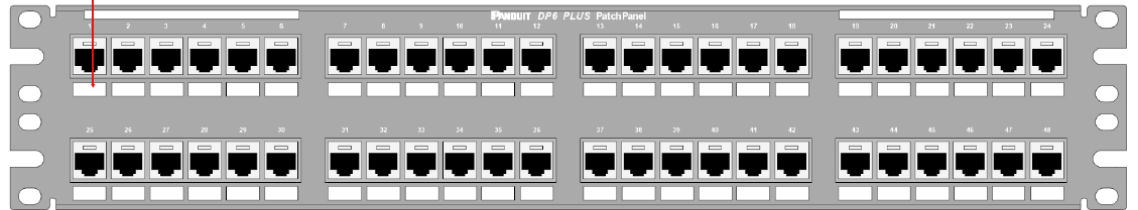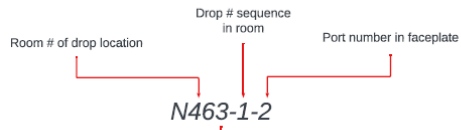

### Labeling for all faceplates

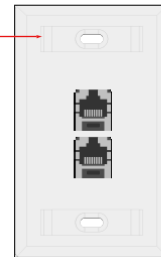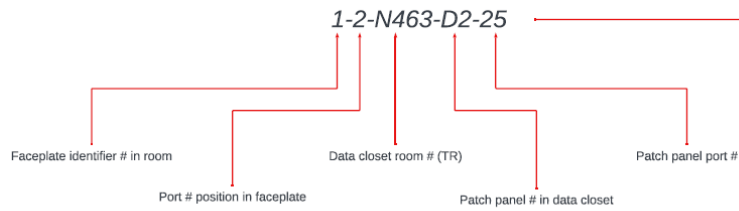

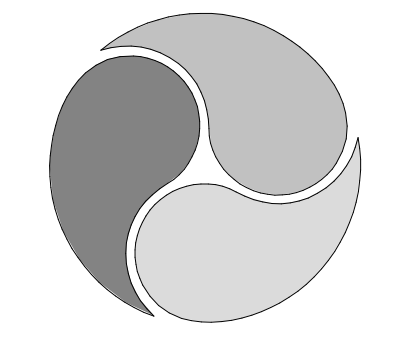

# AE WORKS

418 BEAVER STREET  
SEWICKLEY, PA 15143  
PH: 412.287.7333  
www.aeworks.com

CLIENT:  
**COMMUNITY COLLEGE  
OF ALLEGHENY COUNTY**

595 Beatty Rd  
Monroeville, PA 15146

## BID DOCUMENTS

NO	DATE	REVISION
1	5/13/2026	ADDENDUM 3

PROFESSIONAL:

## PROJECT NAME: CCAC BIOLOGY LAB RENOVATIONS BOYCE CAMPUS

595 Beatty RD, Monroeville PA  
15146

## DRAWING TITLE: ELECTRICAL SYMBOLS AND ABBREVIATIONS

DRAWN BY: JC  
CHECKED BY: DF  
PROJ. NO: CCAC-006  
DATE: 04.14.2026  
DRAWING NO:

# E001

## ELECTRICAL ABBREVIATIONS LIST

1P A AC ACLG ADD AF A.F.F. A.F.G. AFI AHU AL ALUMINUM ALT AMP AMP/L ANNUN APPROX AS-STAT ARCH AS AS AT ATS AUTO AUX AV AWG BATT BOARD BLDG BMS CONDUIT CAB CAT CATV COO/FM CCTV CIT CIRCUIT CLG/CLNG COMB COMP/R CONN CONST CONT CONTR CONV CP CRT CT CT CENTER CU COPPER DCP DDCM DEPT DET DFP DFOM DIA	1 POLE (2P, 3P, 4P, ETC.) DISTRIBUTION ABOVE COUNTER, AIR CONDITIONER ABOVE CEILING AUTOMATIC DOOR OPENER AMP FRAME ABOVE FINISHED FLOOR ABOVE FINISHED GRADE ARC-FAULT CIRCUIT INTERRUPTER AIR HANDLING UNIT ALUMINUM ALTERNATE AMPERE AMPERE-AMPERE ANNUNCIATOR APPROXIMATELY ARCHITECT, ARCHITECTURAL AMP SWITCH AMP TRIP AUTOMATIC AUXILIARY AUDIO VISUAL AMERICAN WIRE GAUGE BATTERY BOARD BUILDING BUILDING MANAGEMENT SYSTEM CONDUIT, CENTER LINE CABINET CATALOG CABLE TELEVISION CIRCUIT BREAKER CLINICAL CENTER OFFICE OF FACILITY MANAGEMENT CLOSED CIRCUIT TELEVISION CENTER FOR INFORMATION TECHNOLOGY CEILING COMBINATION COMPRESSOR CONNECTION CONSTRUCTION CONTINUITY OR CONTINUOUS CONTRACTOR CONVECTOR CIRCUIT TAMP CATHODE-RAY TUBE CURRENT TRANSFORMER CENTER COPPER DOMESTIC WATER CIRCULATING PUMP DIVISION OF DESIGN AND CONSTRUCTION MANAGEMENT DEPARTMENT DETAIL DIVISION OF ENVIRONMENTAL PROTECTION DIVISION OF FACILITIES OPERATIONS AND MAINTENANCE DIVISION OF THE FIRE MARSHAL DIVISION OF FACILITIES PLANNING DIVISION OF FACILITIES STEWARDSHIP DIAMETER	DISCONNECT DOWN DOWN DIVISION OF OCCUPATIONAL HEALTH AND SAFETY DAMPEN DIVISION OF PHYSICAL SECURITY MANAGEMENT DIVISION OF RADIATION SAFETY DISINTEGRATION SWITCH DOUBLE THROW DIVISION OF TECHNICAL RESOURCES DRAWING (DRAWINGS) ELECTRIC, HORIZONTAL ELECTRIC, ELECTRICAL ELEVATOR EMERGENCY ENERGY MANAGEMENT SYSTEM ELECTRIC METALLIC TUBING ELECTRIC PNEUMATIC EQUIPMENT EXISTING TO REMAIN EXISTING EXISTING EXHAUST EXPLOSION PROOF FIRE ALARM FIRE ALARM BOOSTER POWER SUPPLY PANEL FACILITIES NETWORK SYSTEM FIRE ALARM CONTROL PANEL FAN COIL UNIT FLOOR FLUORESCENT FUSE FUSED SAFETY SWITCH GALVANIZED GALLON NOT IN CONTRACT NATIONAL INSTITUTES OF HEALTH NIGHT LIGHT NORMALLY OPEN NORMA. POWER FACTOR NOT TO SCALE ON CENTER OVERHEAD OFFICE OF HOSPITAL PHYSICAL ENVIRONMENT OVERLOADS PUBLIC ADDRESS PULL BOX, PUSH BUTTON PNEUMATIC ELECTRIC PEDESTAL POWER FACTOR PHASE POST INDICATING VALVE PANEL PROJECT OFFICER POWER POLE PAIN PRIMARY PROJECTION POWER ROOF VENTILATOR POTENTIAL TRANSFORMER POLYVINYL CHLORIDE (CONDUIT) INTERLOCK WITH	J-BOX KILOVOLT KVA KILOVOLT-AMPERE REACTIVE KILOWATT KILOWATT-HOUR LOC LIGHT LIGHTING LITING LOW VOLTAGE MAX MAXIMUM MAGNETIC STARTER MOMENTARY CONTACT MECHANICAL CONTRACTOR MAIN CIRCUIT BREAKER MOTOR CONTROL CENTER MAIN DISTRIBUTION CENTER MAIN DISTRIBUTION PANEL MANUFACTURER MAIN FUSED DISCONNECT SWITCH MINIMUM MISCELLANEOUS MAN LUGS ONLY MANUAL MOTOR STARTER MULTIOUTLET ASSEMBLY MOTOR STARTER PANELBOARD MAIN SWITCHBOARD MOUNT EMPTY CONDUIT MANUAL TRANSFER SWITCH MOTOR, MOTORIZED NORMALLY CLOSED NATIONAL ELECTRICAL CODE NEMA ASSOCIATION NON-FUSED SAFETY SWITCH NIC NOT IN CONTRACT NATIONAL INSTITUTES OF HEALTH NIGHT LIGHT NORMALLY OPEN NORMA. POWER FACTOR NOT TO SCALE ON CENTER OVERHEAD OFFICE OF HOSPITAL PHYSICAL ENVIRONMENT OVERLOADS PUBLIC ADDRESS PULL BOX, PUSH BUTTON PNEUMATIC ELECTRIC PEDESTAL POWER FACTOR PHASE POST INDICATING VALVE PANEL PROJECT OFFICER POWER POLE PAIN PRIMARY PROJECTION POWER ROOF VENTILATOR POTENTIAL TRANSFORMER POLYVINYL CHLORIDE (CONDUIT) INTERLOCK WITH	PWR QTY, QUAN RCPT REQUIRED ROOM RSC RIGID STEEL CONDUIT RTU ROOF TOP UNIT SC STEEL CONDUIT SEC SECONDARY SMT SHEET SM SIMILAR SN SOLID NEUTRAL SPEC SPECIFICATION SPEAKER SR SPARE SURF SURFACE RACEWAY SS STAINLESS STEEL SSW SELECTOR SWITCH STA STOP/START PUSHBUTTONS STN STATION STD STANDARD SURF SURFACE MOUNTED SW SWITCH SWBD SWITCHBOARD SYM SYMMETRICAL SYS SYSTEM TEL TELEPHONE TERM TERMINAL TL TWIST LOCK TR TAMPER RESISTANT T-STAT THERMOSTAT TTC TELEPHONE TERMINAL CABINET TR TRUNK TVTC TELEVISION TERMINAL CABINET TYP TYPICAL UC UTILITY COUNTER USC USB-C UE UNDERGROUND ELECTRICAL UES UTILITIES ENGINEERING BRANCH UG UNDERGROUND UH UNIT HEATER UNL UNLESS NOTED OTHERWISE UT UNDERGROUND TELEPHONE UTL UTILITY UV ULTRAVIOLET V VOLT(S) VA VOLT-AMPERE(S) VOL VOLUME W WATT(S) WV WITH WAO WORK AREA OUTLET WG WIRE GUARD WH WATER HEATER WID WITHOUT WIPR WEATHERPROOF XFRM TRANSFORMER Y Y Z FEET INCHES NUMBER PHASE
---	--	--	--	--

## ELECTRICAL SYMBOLS LEGEND

	BRANCH CIRCUITS TO DEVICES OR EQUIPMENT  - SHORT TICKS INDICATE HOTS - LONG TICK INDICATES NEUTRAL - NO TICK MARKS INDICATES ONE HOT AND ONE NEUTRAL  INCLUDE A GROUND CONDUCTOR IN ALL CONDUITS AND RACEWAYS PER NEC REQUIREMENTS. GROUND CONDUCTORS ARE NOT INDICATED WITH TICK MARKS.  REFER TO PANEL SCHEDULES FOR WIRE AND CONDUIT SIZES AND QUANTITIES.	HOME RUN TO INDICATED PANEL AND CIRCUIT NUMBER(S)  - SHORT TICKS INDICATE HOTS - LONG TICK INDICATES NEUTRAL - NO TICK MARKS INDICATES ONE HOT AND ONE NEUTRAL  INCLUDE A GROUND CONDUCTOR IN ALL CONDUITS AND RACEWAYS PER NEC REQUIREMENTS. GROUND CONDUCTORS ARE NOT INDICATED WITH TICK MARKS.  REFER TO PANEL SCHEDULES FOR WIRE AND CONDUIT SIZES AND QUANTITIES.		DASHED GRAY LINES AROUND EQUIPMENT INDICATE NEC REQUIRED CLEARANCES
	SOLID HATCHING OVER LIGHTING FIXTURES INDICATES FIXTURE SHALL BE POWERED VIA LIFE SAFETY CIRCUIT AND RELAYED VIA UL924 LISTED DEVICE FOR FULL BRIGHTNESS DURING FIRE ALARM OR NORMAL POWER LOSS.  REFER TO LIGHTING FIXTURE SCHEDULE FOR ASSOCIATED SYMBOL FOR EACH FIXTURE TYPE.	DASHED SYMBOLS INDICATE ELEMENT TO BE DEMOLISHED  GRAY SYMBOLS INDICATE ELEMENT EXISTING TO REMAIN  WALL MOUNTED JUNCTION BOX, CEILING MOUNTED JUNCTION BOX		EXIT SIGN, WALL MOUNTED CHEVRONS AS INDICATED ON DRAWINGS
	PANELBOARD REFER TO PANEL SCHEDULES FOR ADDITIONAL INFORMATION	POKE THROUGH FLOOR JUNCTION BOX		SINGLE POLE SWITCH
	SAFETY DISCONNECT SWITCH (NON-FUSED) NUMBER OF POLES AND FRAME SIZE AS INDICATED	PULL BOX DIMENSIONS AS INDICATED ON DRAWINGS		TWO POLE, SINGLE POLE SWITCH
	1-PHASE MOTOR EQUIPMENT TAG AS INDICATED	SAFETY DISCONNECT SWITCH (FUSED) NUMBER OF POLES, FRAME SIZE, AND FUSE SIZE AS INDICATED		3-WAY SWITCH
	DUPLEX WALL RECEPTACLE NEMA 5-20R UNLESS NOTED OTHERWISE	3-PHASE MOTOR EQUIPMENT TAG AS INDICATED		4-WAY SWITCH
	DUPLEX WALL RECEPTACLE, ALL OUTLETS SWITCHED VIA LOCAL OCCUPANCY SENSING NEMA 5-20R UNLESS NOTED OTHERWISE	QUADRAPLEX WALL RECEPTACLE NEMA 5-20R UNLESS NOTED OTHERWISE		KEYED SWITCH
	DUPLEX WALL RECEPTACLE WITH ISOLATED GROUND NEMA 5-20R UNLESS NOTED OTHERWISE	QUADRAPLEX WALL RECEPTACLE, ALL OUTLETS SWITCHED VIA LOCAL OCCUPANCY SENSING NEMA 5-20R UNLESS NOTED OTHERWISE		TIMER SWITCH
	DUPLEX FLOOR RECEPTACLE NEMA 5-20R UNLESS NOTED OTHERWISE	QUADRAPLEX WALL RECEPTACLE WITH ISOLATED GROUND NEMA 5-20R UNLESS NOTED OTHERWISE		DIMMER SWITCH
	DUPLEX FLOOR RECEPTACLE, ALL OUTLETS SWITCHED VIA LOCAL OCCUPANCY SENSING NEMA 5-20R UNLESS NOTED OTHERWISE	QUADRAPLEX WALL RECEPTACLE ON EMERGENCY CIRCUIT NEMA 5-20R UNLESS NOTED OTHERWISE		MOMENTARY CONTACT SWITCH
	DUPLEX FLOOR RECEPTACLE WITH ISOLATED GROUND NEMA 5-20R UNLESS NOTED OTHERWISE	QUADRAPLEX FLOOR RECEPTACLE NEMA 5-20R UNLESS NOTED OTHERWISE		OCCUPANCY SENSING SWITCH (AUTOMATIC-ON, AUTOMATIC-OFF)
	NON-TYPICAL NEMA WALL RECEPTACLE CONFIGURATION AS NOTED ON DRAWINGS	QUADRAPLEX FLOOR RECEPTACLE, ALL OUTLETS SWITCHED VIA LOCAL OCCUPANCY SENSING NEMA 5-20R UNLESS NOTED OTHERWISE		VACANCY SENSING SWITCH (AUTOMATIC-ON, AUTOMATIC-OFF)
	NON-TYPICAL NEMA FLOOR RECEPTACLE CONFIGURATION AS NOTED ON DRAWINGS	QUADRAPLEX FLOOR RECEPTACLE WITH ISOLATED GROUND NEMA 5-20R UNLESS NOTED OTHERWISE		OCCUPANCY SENSOR (AUTOMATIC-ON, AUTOMATIC-OFF)
	RECEPTACLE ON CORD REEL (DUPLX SHOWN)	SIMPLEX FLOOR RECEPTACLE NEMA 5-20R UNLESS NOTED OTHERWISE		LIGHT LEVEL SENSOR
	WALL DATA OUTLET ROUGH-IN (18" AFF UNLESS OTHERWISE NOTED) TYPE AND CONFIGURATION AS NOTED ON DRAWINGS	SIMPLEX FLOOR RECEPTACLE ON DROP CORD (DUPLX SHOWN)		WIRELESS ACCESS POINT
	POWER MULTI-OUTLET ASSEMBLY  SYMBOLS INDICATE RECEPTACLE LOCATIONS IN ASSEMBLY	DATA MULTI-OUTLET ASSEMBLY  SYMBOLS INDICATE RECEPTACLE LOCATIONS IN ASSEMBLY		FIRE ALARM SPEAKER STROBE - WALL, CEILING
	FIRE ALARM MANUAL PULL STATION			FIRE ALARM DETECTOR SMOKE DUCT
	FIRE ALARM STROBE - WALL, CEILING			FIRE ALARM DETECTOR HEAT
	FIRE ALARM DETECTOR HEAT			FIRE ALARM DETECTOR SMOKE - CEILING
	FIRE ALARM SPEAKER			FIRE ALARM FLOOR SWITCH
	KIRK KEY INTERLOCK			FIRE ALARM FLOOR SWITCH
	DOOR CONTACT			CARD READER
	ELECTRIC STRIKE			CAMERA
				2X2 TILE CEILING MOUNTED SPEAKER

## ELECTRICAL GENERAL NOTES

- THE FOLLOWING GENERAL NOTES AS LISTED BELOW SHALL APPLY TO ALL ELECTRICAL REQUIREMENTS AS INDICATED ON ALL E SERIES CONTRACT DRAWINGS.
- THE CONTRACTOR IS RESPONSIBLE FOR THE ENTIRE DOCUMENT SET. I.E. IF WORK IS SHOWN ON OTHER DRAWINGS AS "BY CONTRACTOR," THE CONTRACTOR IS RESPONSIBLE FOR THAT WORK.
- DRAWINGS FOR THIS WORK ARE DIAGRAMMATIC AND INTENDED TO CONVEY THE EXTENT, GENERAL ARRANGEMENT AND LOCATIONS OF THE WORK BECAUSE OF THE SCALE OF THE DRAWINGS, CERTAIN BASIC ITEMS SUCH AS ACCESS PANELS, CONDUITS, CABINET SIZES, PENETRATION SLEEVES, PULL BOXES, BACKBOXES AND JUNCTION BOXES MAY NOT BE SHOWN. INCLUDE ALL ITEMS WHERE REQUIRED BY CODE, MANUFACTURER AND RELATED SPECIFICATION SECTIONS FOR THE PROPER INSTALLATION OF ALL WORK.
- DUE TO SCALE OF THE DRAWINGS, ALL ELECTRICAL DEVICE SYMBOLS ARE SHOWN ON DRAWINGS AS CLOSE AS POSSIBLE TO THEIR INTENDED LOCATION, CONTRACTOR SHALL COORDINATE IN THE FIELD THE PROPER INSTALLATION OF ALL EQUIPMENT, DEVICES, CONTROLS AND CONDUITS. REFER TO RELATED SPECIFICATION SECTIONS FOR ADDITIONAL REQUIREMENTS.
- COORDINATE WITH ALL TRADES AND SYSTEM INTEGRATORS ANY CONDITIONS RELATED TO THE INSTALLATION OF ALL SYSTEMS. THE CONTRACTOR SHALL COORDINATE WITH THE APPROPRIATE TRADE ALL INSTALLATION REQUIREMENTS IMPACTING THE PLACEMENT OF ALL SYSTEM COMPONENTS TO THE SATISFACTION OF ALL CONCERNED TRADES.
- COORDINATE EXACT LOCATIONS OF ALL DATA AND TELEPHONE OUTLETS, ELECTRICAL RECEPTACLES WITH THE ARCHITECTURAL PLANS, FURNITURE PLANS AND ALL AFFECTED TRADES PRIOR TO INSTALLATION.
- ALL CONDUITS SHALL BE SIZED AND INSTALLED IN ACCORDANCE WITH NFPA 70 AND PROJECT SPECIFICATIONS. ALL CONDUITS SHALL BE A MINIMUM OF 3/4" UNLESS OTHERWISE NOTED.
- PROVIDE ALL CLEARANCES IN ACCORDANCE WITH NEC REQUIREMENTS. ARRANGE EQUIPMENT TO FACILITATE UNRESTRICTED ACCESS FOR MAINTENANCE AND SERVICE AROUND ALL EQUIPMENT, COMPONENTS AND/OR CABLE TERMINATIONS.
- WHERE EQUIPMENT AND/OR JUNCTION BOXES ARE INSTALLED ABOVE FINISHED CEILING, THE CONTRACTOR SHALL PROVIDE ACCESS HATCHES LISTED FOR THE INTENDED APPLICATION. ACCESS HATCHES SHALL BE LOCATED SO THAT SERVICE ACCESS TO THE EQUIPMENT AND/OR JUNCTION BOXES IS UNIMPEDED.
- ALL PENETRATIONS OF WALLS AND/OR FLOORS SHALL BE FIRE STOPPED IN ACCORDANCE WITH THE ASTM AND NFPA REQUIREMENTS. REFER TO RELATED SPECIFICATION SECTIONS FOR ADDITIONAL INFORMATION. INSTALLATION OF FIRE STOPS SHALL BE PERFORMED BY APPLICATOR/INSTALLER QUALIFIED AND TRAINED BY THE MANUFACTURER. INSTALLATION SHALL BE PERFORMED IN STRICT ACCORDANCE WITH MANUFACTURER'S DETAILED INSTALLATION PROCEDURES.
- ALL EQUIPMENT ENCLOSED LOCATED OUTSIDE OR IN ALL AREAS WITH HIGH MOISTURE OR A RELATIVE HUMIDITY OF 75% OR GREATER SHALL BE NEMA 4X STAINLESS STEEL AND RATED FOR THAT APPLICATION.
- ALL INTERIOR AND/OR EXTERIOR COMPONENTS, DEVICES OR SYSTEMS EXPOSED TO THE GENERAL POPULATION SHALL BE INSTALLED IN SECURED EQUIPMENT ENCLOSEURES WITH TAMPER SWITCHES AND INSTALLED IN SUCH A MANNER THAT RESISTS TAMPERING AND/OR REMOVAL WITHOUT THE USE OF SPECIALIZED TOOLS.
- FOR EQUIPMENT INSTALLATIONS REQUIRING COORDINATION WITH OTHER TRADES, THE CONTRACTOR SHALL PROVIDE ALL TEMPLATES, BACKBOXES AND EQUIPMENT AND/OR BOLS FOR MOUNTING OR FLUSH MOUNTING PREPARATION (E.G. PEDESTALS OR OTHER DEVICES REQUIRING MOUNTING ON WALLS, CONCRETE PADS OR OTHER MATERIALS). COORDINATE DELIVERY OF TEMPLATES AND EQUIPMENT WITH ALL AFFECTED CONTRACTORS.
- ALL ELECTRICAL WORK SHALL BE DONE IN ACCORDANCE WITH THE NATIONAL ELECTRIC CODE (LATEST VERSION BEING ENFORCED) AND ALL OTHER APPLICABLE CODES AND STANDARDS BEING ENFORCED BY THE AGENCY HAVING JURISDICTION.
- THESE DRAWINGS DO NOT INCLUDE NECESSARY COMPONENTS OR INSTRUCTIONS FOR CONSTRUCTION SAFETY. THE ENGINEER ASSUMES NO RESPONSIBILITY FOR ANY WORKMAN'S OR TRANSPORT'S SAFETY, OR FOR THE ADEQUACY OF EQUIPMENT, BUILDING COMPONENTS, WORK AIDS, OR ANY NECESSITY TO WORK ON ENERGIZED ELECTRICAL COMPONENTS. FURTHER, NO SUPERINTENDENCE IS INCLUDED OR IMPLIED.
- ALL SYSTEMS AND EQUIPMENT SHALL BE INSTALLED AND WIRED ACCORDING TO THE MANUFACTURER'S RECOMMENDATIONS.
- ALL ELECTRICAL MATERIALS, DEVICES, APPLIANCES, AND EQUIPMENT SHALL BE TESTED AND LISTED BY A NATIONALLY RECOGNIZED TESTING LABORATORY.
- THE CONTRACTOR SHALL COORDINATE CONDUIT ROUTING (PLAN AND ELEVATION) WITH THE LIGHTING (NEW AND EXISTING), CEILING ELEVATION, STRUCTURE, DUCTWORK, PIPING, ETC. REQUIRED FOR THE COMPLETION OF THE PROJECT, PRIOR TO INSTALLATION.
- THE CONTRACTOR SHALL SECURE AND PROTECT THE BUILDING AND/OR WORK AREA WITH FIRE RETARDANT TEMPORARY PLYWOOD PARTITIONS (WITH LOCKING DOORS), ETC. CLOSE ALL EXISTING OPENINGS AS REQUIRED. COORDINATE THIS WORK WITH THE OWNER'S REPRESENTATIVE PRIOR TO STARTING. IF TEMPORARY PARTITIONS IMPROVE THE FLOW OF EQUIPMENT TO REQUIRED EGRESS DOORS AND STAIRS, THE CONTRACTOR SHALL PROVIDE EXIT SIGNS, AND SIGNAGE INDICATING SUCH.
- THE CONTRACTOR SHALL CALLK ALL JOINTS BETWEEN METAL FRAMES AND EXISTING CONDITIONS. THIS APPLIES TO BOTH INTERIOR AND EXTERIOR INSTALLATIONS.
- ALL DIMENSIONS SHOWN ON THE DRAWINGS ARE FOR THE CONVENIENCE OF THE CONTRACTOR ONLY. VERIFY ALL DIMENSIONS IN THE FIELD PRIOR TO PERFORMING ANY WORK.
- THE CONTRACTOR SHALL INSTALL ALL CONDUITS CONCEALED UNLESS NOTED OTHERWISE. EXPOSED CONDUIT SHALL ONLY BE INSTALLED IN CHASES, EXPOSED CEILING AREAS, JANITOR CLOSETS, AND MECHANICAL/ELECTRICAL ROOMS.
- ALL ELECTRICAL EQUIPMENT SHALL BE GROUNDED AND/OR BONDED PER THE REQUIREMENTS OF THE NATIONAL ELECTRIC CODE. PROVIDE ALL GROUNDING AND/OR BONDING COMPONENTS NOT EXPLICITLY SHOWN ON THE DOCUMENTS.
- THE CONTRACTOR SHALL PROVIDE UPDATED TYPED PANELBOARD DIRECTORIES, INDICATING THE LOADS SERVED BY THE RESPECTIVE PANELS. AMEND AS REQUIRED FOR AS-BUILT CONDITIONS. PROVIDE ELECTRONIC VERSIONS OF THE PANELBOARD SCHEDULES FOR FUTURE USE BY THE OWNER.
- THE CONTRACTOR SHALL REVIEW THE WORK REQUIRED WITH THE APPLICABLE UTILITY COMPANIES SERVING THE PROJECT. ALL WORK PERFORMED SHALL BE IN ACCORDANCE WITH THE REQUIREMENTS OF THE INDIVIDUAL UTILITY COMPANIES.

## ELECTRICAL GENERAL NOTES

- THE CONTRACTOR SHALL COORDINATE ALL WORK WITH THE OWNER PRIOR TO STARTING ALL PHASES OF THE PROJECT. THE CONTRACTOR SHALL COORDINATE WITH THE OWNER WHAT WORK, IF ANY, HAS TO BE COMPLETED DURING SECOND OR THIRD SHIFT.
- THE CONTRACTOR SHALL PROVIDE ALL TEMPORARY POWER CONNECTIONS TO KEEP AREAS UP AND OPERATIONAL DURING THE CONSTRUCTION. THE CONTRACTOR SHALL COORDINATE THESE REQUIREMENTS WITH THE OWNER.
- THE VERBIAGE ON THE DRAWINGS INDICATING TYPES OF MATERIALS TO BE ENCOUNTERED IS INTENDED TO AID THE ELECTRICAL CONTRACTOR IN UNDERSTANDING THE VARIOUS CONDITIONS LIKELY TO BE ENCOUNTERED. THE CONTRACTOR SHALL BE RESPONSIBLE FOR DETERMINING QUANTITIES OF MATERIALS REQUIRED TO COMPLETE THE PROJECT.
- THE LOCATIONS OF EXISTING UTILITIES, STRUCTURE, AND OTHER CONDITIONS SHOWN ON THE PLANS ARE APPROXIMATE. IT SHALL BE THE RESPONSIBILITY OF THE CONTRACTOR TO VERIFY AND REPORT ANY DISCREPANCIES TO THE ENGINEER PRIOR TO BEGINNING ANY WORK.
- FURNISH AND INSTALL ALL REQUIRED UNTELS AND SLEEVES. ALL CONDUITS SHALL HAVE SLEEVES INSTALLED. ALL SLEEVES INSTALLED THROUGH EXTERIOR WALLS SHALL HAVE LINK SEALS INSTALLED.
- THE CONTRACTOR SHALL MAINTAIN THE BUILDING IN WEATHERTIGHT AND WATERPROOF CONDITION THROUGHOUT THE DURATION OF THEIR WORK. DO NOT LEAVE HOLES THROUGH WALLS AND/OR ROOFS OPEN TO THE ELEMENTS WHEN NO WORK IS OCCURRING IN THOSE AREAS.
- THE CONTRACTOR SHALL GENERATE A DETAILED METHOD OF PROCEDURE (MOP) DOCUMENT INDICATING HOW HE/SHE INTENDS TO PERFORM EACH STEP IN THE PROJECT. THIS MOP SHALL BE PRESENTED TO THE OWNER AND ENGINEER FOR SIGN OFF PRIOR TO STARTING THE PROJECT. THE MOP MAY BE REVISED BASED ON CHANGES IN THE PROJECT CONSTRUCTION, ETC. AT ALL POINTS IN THE PROJECT THE OWNER SHALL BE MADE AWARE OF CHANGES TO THE MOP, AND A REVISED MOP SHALL BE PRESENTED TO THE OWNER AND ENGINEER FOR SIGN OFF.
- PROVIDE ALL JUNCTION BOXES, PULL BOXES AND OTHER PULL POINTS AS REQUIRED FOR EASE OF PULLING AND TO MEET THE MAXIMUM NUMBER OF BENDS PER NEC REQUIREMENTS FOR A CODE COMPLIANT INSTALLATION. NOT ALL CONDUITS, PULL BOXES AND OTHER RACEWAY ITEMS ARE INDICATED ON THE DOCUMENTS. THE CONTRACTOR SHALL PROVIDE A COMPLETE RACEWAY SYSTEM MEETING THE REQUIREMENTS OUTLINED IN THE DRAWINGS AND SPECIFICATIONS. ALL JUNCTION BOXES AND OTHER PULL POINTS SHALL BE ACCESSIBLE.
- DISTRIBUTION EQUIPMENT SHALL BE A/C RATED, AND ANY CIRCUIT BREAKERS SELECTED AND SET BASED ON THE OUTCOME OF THE CONTRACTORS OVERCURRENT PROTECTIVE DEVICE COORDINATION STUDY. STUDY SHALL INCLUDE ALL ELEMENTS OF THE EXISTING AND NEW DISTRIBUTION SYSTEM REQUIRED TO ACCURATELY SIZE AND RATE THE NEW EQUIPMENT ADDED AS PART OF THIS PROJECT.
- ARC FLASH LABELS SHALL BE PROVIDED TO ALL NEW EQUIPMENT BASED ON THE OUTCOME OF THE CONTRACTORS ARC FLASH STUDY. ANY EQUIPMENT MODDED AS PART OF THIS PROJECT SHALL ALSO BE INCLUDED IN THE ARC FLASH STUDY AND SHALL BE RELEASED AS REQUIRED.
- THESE DRAWINGS DO NOT INDICATE ALL CONDUITS INTERCONNECTING EQUIPMENT, AND WHERE CONDUITS ARE INDICATED, THE ROUTING IS APPROXIMATE. THE CONTRACTOR IS RESPONSIBLE FOR THE ROUTING AND INSTALLATION OF ALL CONDUIT IN COORDINATION WITH OTHER TRADES AND EXISTING CONDITIONS.
- MULTI-WIRE BRANCH CIRCUITS ARE NOT PERMITTED. ALL SINGLE POLE BRANCH CIRCUITS SHALL HAVE A DEDICATED NEUTRAL. SHARING OF NEUTRALS IS PROHIBITED. ALL CIRCUITS SHALL CONTAIN AN INDIVIDUAL GROUND WIRE. USE OF THE CONDUIT SYSTEM FOR THE GROUND PATH IS PROHIBITED.
- MULTI-POLE SMALL 20A/1 BRANCH CIRCUITS MAY SHARE A SINGLE CONDUIT PROVIDED THE CONTRACTOR SIZES THE WIRES (INCLUDING THE GROUND AND CONDUIT AS REQUIRED PER NEC).
- THE COMPLETE BRANCH WIRING SYSTEM IS NOT SHOWN ON THE DRAWINGS. AN ABBREVIATED FORMAT IS USED TO INDICATE WHICH FUTURES/DEVICES ARE CONNECTED TO A COMMON CIRCUIT OR SWITCH. THIS IS PROVIDED AS A GUIDE TO THE CONTRACTOR TO ILLUSTRATE CIRCUITS AND CONTROL INTENT. ACTUAL WIRING MAY DIFFER DUE TO FIELD CONDITIONS. COLOR CODING OF WIRES SHALL BE AS PER NEC.
- PROVIDE 120V 20A 5-20R RECEPTACLE AT ALL FAN COIL UNITS FOR CONDENSATE PUMP FLOW AND HOT WATER RECIRCULATING PUMPS, WHETHER SHOWN ON PLANS OR NOT. RECEPTACLE IS TO BE CONNECTED TO NEAREST 120V RECEPTACLE CIRCUIT.
- PROVIDE 120V CONNECTION TO ALL MOTORIZED DAMPERS INDICATED ON MECHANICAL PLANS, WHETHER SHOWN ON DIVISION 26 DRAWINGS OR NOT. FUTURE/SHAKE DAMPER CIRCUITS ARE TO BE PROVIDED FROM EMERGENCY (LIFE SAFETY) BRANCH PANEL. MOTORIZED DAMPERS WITHIN THE SAME AREA CAN BE CIRCUITED TO THE SAME CIRCUIT (I.E. DEDICATED CIRCUIT IS NOT REQUIRED).
- DURING THE BIDDING PROCESS, THE ELECTRICAL CONTRACTOR SHALL REVIEW DRAWINGS AND SPECIFICATIONS OF ALL OTHER TRADES (ARCHITECTURAL, SITE/LANDSCAPING, HVAC, PLUMBING, AND SPECIALTY TRADES). ALL ITEMS REQUIRING POWER INDICATED ON THESE DRAWINGS BUT NOT INDICATED ON THE ELECTRICAL DRAWINGS SHALL BE CONSIDERED A PART OF THE ELECTRICAL CONTRACTOR'S WORK. THIS WORK SHALL BE INSTALLED AS PER NEC REQUIREMENTS AT NO ADDITIONAL COST TO THE OWNER.
- GENERAL CONTRACTOR SHALL SURVEY AND DOCUMENT EXISTING CEILING GRID AND DEVIATE LAYOUT PRIOR TO ALL ABOVE CEILING WORK. SURVEY SHALL BE BASED ON OVERLAP WORK COORDINATION WITH ALL PRIME CONTRACTORS AND SUBMITTAL FOR APPROVAL OF WORK.
- ALL PRIME CONTRACTORS SHALL COORDINATE TO PROVIDE A SINGLE PHASING PLAN SUBMITTAL FOR REVIEW AND APPROVAL FROM OWNER. ALL WORK AREAS PRIOR TO START OF WORK. PHASING PLAN SUBMITTAL SHALL INCLUDE AREAS OF WORK PER PHASE, TYPE OF WORK PER PHASE, DURATION OF EACH PHASE, LOCATION OF EACH PHASE, AND PHOTOS OF EXISTING CONDITIONS PRIOR TO START OF WORK. GENERAL CONTRACTOR SHALL ASSEMBLE AND GENERATE COMBINED SUBMITTAL.
- GENERAL CONTRACTOR SHALL PROVIDE DUST CONTAINMENT ENCLOSURE AT EACH PHASE OF WORK.
- ALL PRIME CONTRACTORS SHALL REMOVE CEILING AREAS AS REQUIRED TO PERFORM 6TH FLOOR UNDERSLAB WORK FOR LAB RENOVATIONS.
- ALL PRIME CONTRACTORS SHALL REINSTALL ALL REMOVED CEILING GRID, TILE, AND DEVICES AT THE COMPLETION OF EACH PHASE BEFORE BEGINNING THE NEXT PHASE.
- ALL PRIME CONTRACTORS SHALL COORDINATE WORK TO OCCUR OVER SUMMER HOLIDAY BREAKS, AND WEEKENDS TO MINIMIZE DISRUPTION TO STUDENT SERVICES.
- REFER TO G102 PHASING PLAN FOR LOCATION OF CONSTRUCTION BARRIERS AND AREA OF WORK AVAILABLE FOR DURATION OF PROJECT AT 6TH FLOOR.
- PHASE WORK TO MAINTAIN ACCESS TO ONE TOILET ROOM DURING ENTIRE DURATION OF CONSTRUCTION.

## FIRE ALARM GENERAL NOTES

- THE FOLLOWING GENERAL NOTES AS LISTED BELOW SHALL APPLY TO ALL FIRE ALARM SYSTEM SCOPING OR WORK INSTALLED ON THE E SERIES DRAWINGS.
- ALL EQUIPMENT SYMBOLS ARE SHOWN ON DRAWINGS AS CLOSE AS POSSIBLE TO THEIR INTENDED LOCATION. CONTRACTOR SHALL COORDINATE IN THE FIELD THE PROPER INSTALLATION OF ALL EQUIPMENT, DEVICES, CONTROLS AND CABLING. REFER TO RELATED SPECIFICATION SECTIONS FOR ADDITIONAL REQUIREMENTS.
- DRAWINGS FOR THIS WORK ARE DIAGRAMMATIC AND INTENDED TO CONVEY THE EXTENT, GENERAL ARRANGEMENT AND LOCATIONS OF THE WORK BECAUSE OF THE SCALE OF THE DRAWINGS, CERTAIN BASIC ITEMS SUCH AS ACCESS PANELS, CONDUITS, CABINET SIZES, PENETRATION SLEEVES, PULL BOXES, BACKBOXES AND JUNCTION BOXES MAY NOT BE SHOWN. INCLUDE ALL ITEMS WHERE REQUIRED BY CODE, MANUFACTURER AND RELATED SPECIFICATION SECTIONS FOR THE PROPER INSTALLATION OF ALL WORK.
- THE SYSTEM SHALL BE INSTALLED IN ACCORDANCE WITH ARTICLE 760 OF THE 2017 NATIONAL ELECTRIC CODE. ALL FIRE ALARM CABLE MUST BE MARKED TYPE FPL (NON PLENUM) OR FRP (PLENUM) AND PROVIDED IN ACCORDANCE WITH THE CABLING REQUIREMENTS SPECIFIED BY THE CONTRACT DOCUMENTS.
- FIRE ALARM DEVICE MOUNTING HEIGHTS SHALL COMPLY WITH ALL ANS I 117, NFPA 72, AND IBC REQUIREMENTS AT THE MINIMUM. INSTALL ALL DEVICES AS SHOWN ON THE MOUNTING DETAIL ON THIS SHEET.
- COORDINATE WITH ALL TRADES ALL CONDITIONS RELATED TO THE INSTALLATION OF ALL DEVICES. THE CONTRACTOR SHALL COORDINATE WITH THE APPROPRIATE TRADE ALL INSTALLATION REQUIREMENTS IMPACTING THE PLACEMENT OF ALL SYSTEM COMPONENTS TO THE SATISFACTION OF ALL CONCERNED TRADES.
- PROVIDE ALL EQUIPMENT CLEARANCES IN ACCORDANCE WITH NFPA 70 REQUIREMENTS. ARRANGE EQUIPMENT TO FACILITATE UNRESTRICTED ACCESS FOR MAINTENANCE AND SERVICE AROUND ALL EQUIPMENT, COMPONENTS AND/OR CABLE TERMINATIONS.
- COORDINATE EXACT LOCATIONS OF ALL CEILING MOUNTED CABLE, CONDUITS, EQUIPMENT AND/OR DEVICES WITH ALL ARCHITECTURAL PLANS, REFLECTED CEILING PLANS AND AFFECTED TRADES PRIOR TO INSTALLATION.
- ALL SMOKE AND HEAT DETECTORS SHALL BE MOUNTED TO FINISHED CEILING AND/OR DECKING, UNLESS NOTED OTHERWISE. DETECTORS SHALL NOT BE INSTALLED ON BOTTOM OF OPEN WEB JOISTS OR ON BEAMS EXCEEDING 12 INCHES DEPTH FROM FINISHED CEILING OR DECK. REFER TO NFPA 72 FOR ALL INITIATING DEVICE INSTALLATION REQUIREMENTS. PROVIDE DETECTORS IN SUFFICIENT QUANTITY TO COMPLY WITH ALL NFPA 72 REQUIREMENTS BASED ON CEILING CONDITIONS AND PROTECTED SPACE REQUIREMENTS.
- PROTECTIVE ANTI-DUST COVERS SHALL BE INSTALLED AND MAINTAINED ON ALL SYSTEM SMOKE DETECTORS UNTIL FINAL ACCEPTANCE BY THE AUTHORITIES HAVING JURISDICTION.
- SMOKE DETECTORS SHALL NOT BE INSTALLED LESS THAN 3 FEET FROM ANY HVAC SUPPLY OR RETURN AIR REGISTER AND A MINIMUM OF 1 FOOT AWAY FROM ALL LIGHTING FIXTURES.
- WHERE EQUIPMENT AND/OR JUNCTION BOXES ARE INSTALLED ABOVE FINISHED CEILING, THE CONTRACTOR SHALL PROVIDE ACCESS HATCHES LISTED FOR THE INTENDED APPLICATION. ACCESS HATCHES SHALL BE LOCATED SO THAT SERVICE ACCESS TO THE EQUIPMENT AND/OR JUNCTION BOXES IS UNIMPEDED.
- THE FIRE ALARM SYSTEM CABLING SHALL BE INSTALLED IN DEDICATED CONDUITS. ALL CONDUITS SHALL BE INSTALLED IN ACCORDANCE WITH NFPA 70 AND THE CONTRACT DOCUMENTS. ALL CONDUITS SHALL BE SIZED IN ACCORDANCE WITH NFPA 70 AND SHALL BE A MINIMUM OF 3/4" UNLESS OTHERWISE NOTED. REFER TO RELATED SPECIFICATION SECTIONS FOR ADDITIONAL INFORMATION.

## FIRE ALARM GENERAL NOTES

- ALL CONDUITS/RACEWAYS SHALL BE INSTALLED IN A MANNER THAT PREVENTS SYSTEM SCOPING OR WORK INSTALLED ON THE GENERAL POPULATION. PROVIDE TAMPER-RESISTANT INSTALLATION UTILIZING "TORK WITH PEG" SECURITY-FASTENING DEVICES FOR ALL CONDUITS/RACEWAYS, EQUIPMENT, DEVICES AND APPURTENANCES IN ALL AREAS ACCESSIBLE TO THE GENERAL POPULATION AND/OR AREAS SUBJECT TO TAMPERING OR VANDALISM. REFER TO RELATED SPECIFICATION SECTIONS FOR ADDITIONAL INFORMATION.
- PROVIDE APPROVED EARTH GROUND AT FIRE ALARM CONTROL PANEL CHASSIS. A CONDUIT GROUNDING TO BUILDING STEEL SHALL NOT BE CONSIDERED AN ACCEPTABLE METHODOLOGY FOR GROUNDING OF FIRE ALARM CONTROL PANEL.
- ALL SYSTEM WIRING AND EQUIPMENT INSTALLATIONS SHALL BE IN ACCORDANCE WITH GOOD ENGINEERING PRACTICES AND BY ALL IEEE, EIA, NEC, AND MANUFACTURER'S REQUIREMENTS. WIRING SHALL COMPLY WITH ALL STATE AND LOCAL ELECTRICAL CODES. ALL WIRING SHALL TEST FREE FROM ALL GROUNDS, SHORTS AND EMI.
- NO A.C. CARRYING CONDUCTORS ARE PERMITTED TO SHARE RACEWAYS WITH ANY FIRE ALARM INITIATING AND/OR NOTIFICATION CIRCUITS.
- ALL A.C. ELECTRICAL CIRCUITS FEEDING THE FIRE ALARM CONTROL EQUIPMENT SHALL BE EQUIPPED WITH DEDICATED CIRCUIT BREAKER/LOCKOUT DEVICE IN ACCORDANCE WITH NFPA 72.
- THE CONTRACTOR SHALL METER ALL WIRES AND CIRCUITS TO ENSURE THEY ARE FREE OF ANY GROUNDS AND SHORTS PRIOR TO COMMISSIONING OF THE SYSTEM.
- ALL AUXILIARY ALARM RELAYS MUST BE INSTALLED WITHIN 3 FEET OF THE EQUIPMENT TO BE CONTROLLED IN ACCORDANCE WITH ALL NFPA 72 REQUIREMENTS.
- ALL FIRE ALARM DEVICES AND EQUIPMENT SHALL BE LABELED WITH A UNIQUE IDENTIFICATION NUMBER. ALL NUMBERS SHALL CORRESPOND WITH NUMBERING SEQUENCE AS SUBMITTED ON THE PROJECT SHOP DRAWINGS. LABELS TO BE SIMILAR TO "BROTHER ELECTRIC" BLACK LETTERING ON WHITE BACKGROUND AND SELF-ADHESIVE TAPE. ALL DEVICE LABELS SHALL BE INSTALLED PRIOR TO SYSTEM CHECKOUT.
- ALL PENETRATIONS OF WALLS AND FLOORS SHALL BE FIRE STOPPED IN ACCORDANCE WITH THE ASTM AND NFPA REQUIREMENTS. REFER TO RELATED SPECIFICATION SECTIONS FOR ADDITIONAL INFORMATION. INSTALLATION OF FIRE STOPS SHALL BE PERFORMED BY APPLICATOR/INSTALLER QUALIFIED AND TRAINED BY THE MANUFACTURER. INSTALLATION SHALL BE PERFORMED IN STRICT ACCORDANCE WITH MANUFACTURER'S DETAILED INSTALLATION PROCEDURES.
- REFER TO ALL RELATED SPECIFICATION SECTIONS FOR ADDITIONAL INFORMATION.
- ALL EQUIPMENT ENCLOSED LOCATED OUTSIDE OR IN ALL AREAS WITH HIGH MOISTURE OR A RELATIVE HUMIDITY OF 75% OR GREATER SHALL BE NEMA 4X ENCLOSEURES AND RATED FOR THAT APPLICATION.
- ALL EQUIPMENT EXPOSED TO THE ENVIRONMENT OR INSTALLED IN PROXIMITY TO AREAS WITH HIGH MOISTURE, OR A RELATIVE HUMIDITY OF 75% OR GREATER, SHALL BE PROVIDED WITH ENCLOSURES AND/OR BACKBOXES RATED FOR THE ENVIRONMENTAL CONDITIONS.
- THE STROBE INTENSITY OF ALL VISUAL NOTIFICATION APPLIANCES SHALL BE IN ACCORDANCE WITH NFPA 72 AND UL 1971. STROBE CANDELA RATINGS SHALL BE PROVIDED IN ACCORDANCE WITH DEVICE LOCATIONS AND SHALL CONFORM TO ALL IGCANS 117 AND NFPA 72 INSTALLATION REQUIREMENTS. CONTRACTOR SHALL PROVIDE THE REQUIRED CANDELA POWER AND LOCATE ALL VISUAL NOTIFICATION APPLIANCES AS REQUIRED TO MEET THE REQUIREMENTS OF ALL REFERENCED CODES AND STANDARDS.

GENERAL NOTES - UNDERFLOOR WORK

- 1 CONTRACTOR SHALL PROVIDE A PHASING PLAN OF ALL WORK AREAS FOR REVIEW BY THE OWNER PRIOR TO CEILING REMOVAL. OBTAIN WRITTEN APPROVAL FROM OWNER PRIOR TO START OF WORK.
- 2 CONTRACTOR SHALL PROVIDE DUST CONTAINMENT ENCLOSURE AT EACH PHASE OF WORK.
- 3 COORDINATE WORK WITH ALL PRIME CONTRACTORS TO OCCUR OVER SUMMER AND HOLIDAY BREAKS AND WEEKENDS TO MINIMIZE DISRUPTION TO STUDENT SERVICES.

ELECTRICAL DEMOLITION GENERAL NOTES

- 1 UNLESS NOTED OTHERWISE, REMOVE ALL ELECTRICAL DEVICES FROM WITHIN THE AREA OF DEMOLITION WORK IDENTIFIED. THE DEVICES TO BE REMOVED SHALL INCLUDE BUT ARE NOT LIMITED TO: RECEPTACLES, FIRE ALARM DEVICES AND TERMINAL CABINETS, SWITCHES, JUNCTION BOXES, LIGHTS, LIGHTING CONTROLS, PANELBOARDS AND FLOOR BOXES. REMOVE ALL ASSOCIATED CONDUIT AND WIRE BACK TO THE UPSTREAM DISTRIBUTION DEVICE. THE INTENT IS FOR ALL DEVICES TO BE REMOVED TO ALLOW THE RENOVATION AND INSTALLATION OF ALL NEW DEVICES AS SHOWN ON THE NEW WORK DOCUMENTS. EXISTING DEVICES SHOWN ARE DIAGNOSTIC AND BASED ON FIELD SURVEYS AND/OR RECORD DRAWINGS PROVIDED BY THE OWNER AND DO NOT REPRESENT THE FULL SCOPE OF DEMOLITION WORK. THE ACTUAL CONDITIONS MAY VARY. ALL EXISTING CONDITIONS MUST BE VERIFIED PRIOR TO BID. THE PLANS ARE INTENDED TO SHOW THE LOCATIONS OF EXISTING DEVICES AND IN NO WAY RELIEVE THE CONTRACTOR FROM PROVIDING ANY AND ALL COORDINATION NECESSARY TO COMPLETE THE NEW WORK. FIELD CONDITIONS SHALL GOVERN. FIELD VERIFY ALL EXISTING CONDITIONS AND DIMENSIONS PRIOR TO COMMENCEMENT OF WORK AND OBTAIN CLARIFICATIONS FROM ARCHITECT/ENGINEER IF NECESSARY. COMPONENTS RELATED TO THE EXISTING BUILDING-WIDE LIGHTING CONTROL SYSTEM SHALL BE RETAINED AND REUSED WHERE FEASIBLE WITH NEW LIGHTING AND CONTROL DEVICES.
- 2 CONTRACTOR SHALL PROVIDE A MINIMUM TWO WEEKS WRITTEN NOTICE PRIOR TO ANY SHUT DOWN. NOTICE IS TO INCLUDE BUT IS NOT LIMITED TO THE LOCATION, PANELS AND DURATION OF SHUT DOWN.
- 3 OWNER SHALL HAVE RIGHT OF FIRST REFUSAL TO ANY EQUIPMENT, DEVICES, LUMINAIRES, ETC. DEMOLISHED FROM RENOVATION AREA PRIOR TO DISPOSAL.
- 4 MAINTAIN CONTINUITY OF SERVICE TO AREAS OUTSIDE THE PROJECT BOUNDARY. PATCH AND REPAIR ALL CIRCUITS CUT OFF DURING DEMOLITION BY WIRING METHODS COMPATIBLE WITH THE EXISTING INSTALLATION.
- 5 THE ELECTRICAL CONTRACTOR SHALL REVIEW THE DRAWINGS OF ALL OTHER TRADES IN THIS CONTRACT. THE REMOVAL OF ELECTRICAL SERVICE TO ALL EQUIPMENT IDENTIFIED ON OTHER TRADE DRAWINGS IS THE RESPONSIBILITY OF THE ELECTRICAL CONTRACTOR.
- 6 EXERCISE EXTREME CAUTION WHEN REMOVING/RELOCATING WIRING AND EQUIPMENT. IT IS THE CONTRACTORS RESPONSIBILITY TO ENSURE THAT OTHER WIRING DEVICES, EQUIPMENT AND LIGHT FIXTURES THAT MAY BE CONNECTED TO THE SAME CIRCUIT REMAIN OPERATIONAL AND ACTIVE.
- 7 CONTRACTOR SHALL EXAMINE CONDITIONS AND TEST FUNCTIONALITIES OF ALL EXISTING ELECTRICAL EQUIPMENT IDENTIFIED TO BE REUSED AND/OR RELOCATED. PROVIDE REPORT TO ENGINEER AND OWNER PRIOR TO DEMOLITION.
- 8 NOT APPLICABLE.
- 9 NOT APPLICABLE.
- 10 NOT APPLICABLE.

ELECTRICAL DEMOLITION KEYNOTES

- 1 UNLESS OTHERWISE NOTED, ALL EXISTING LIGHT FIXTURES, EXISTING SIGNS, AND LIGHTING CONTROLS ARE TO BE REMOVED AND REPLACED WITH NEW. ALL ASSOCIATED WIRING AND CONDUIT SHALL BE DEMOLISHED BACK TO SOURCE.
- 2 EXISTING LIGHT FIXTURE IS EXISTING TO REMAIN.
- 3 NOT USED.
- 4 EXISTING LIGHT FIXTURE IS EXISTING TO REMAIN.
- 5 DEMOLISH FIXTURE AND RETURN TO OWNER. EXISTING BRANCH CIRCUITING TO REMAIN FOR CONNECTION TO NEW LIGHT FIXTURES.
- 6 EXISTING LIGHT FIXTURES IN THIS AREA ARE EXISTING TO REMAIN.


E

D

C

B

A

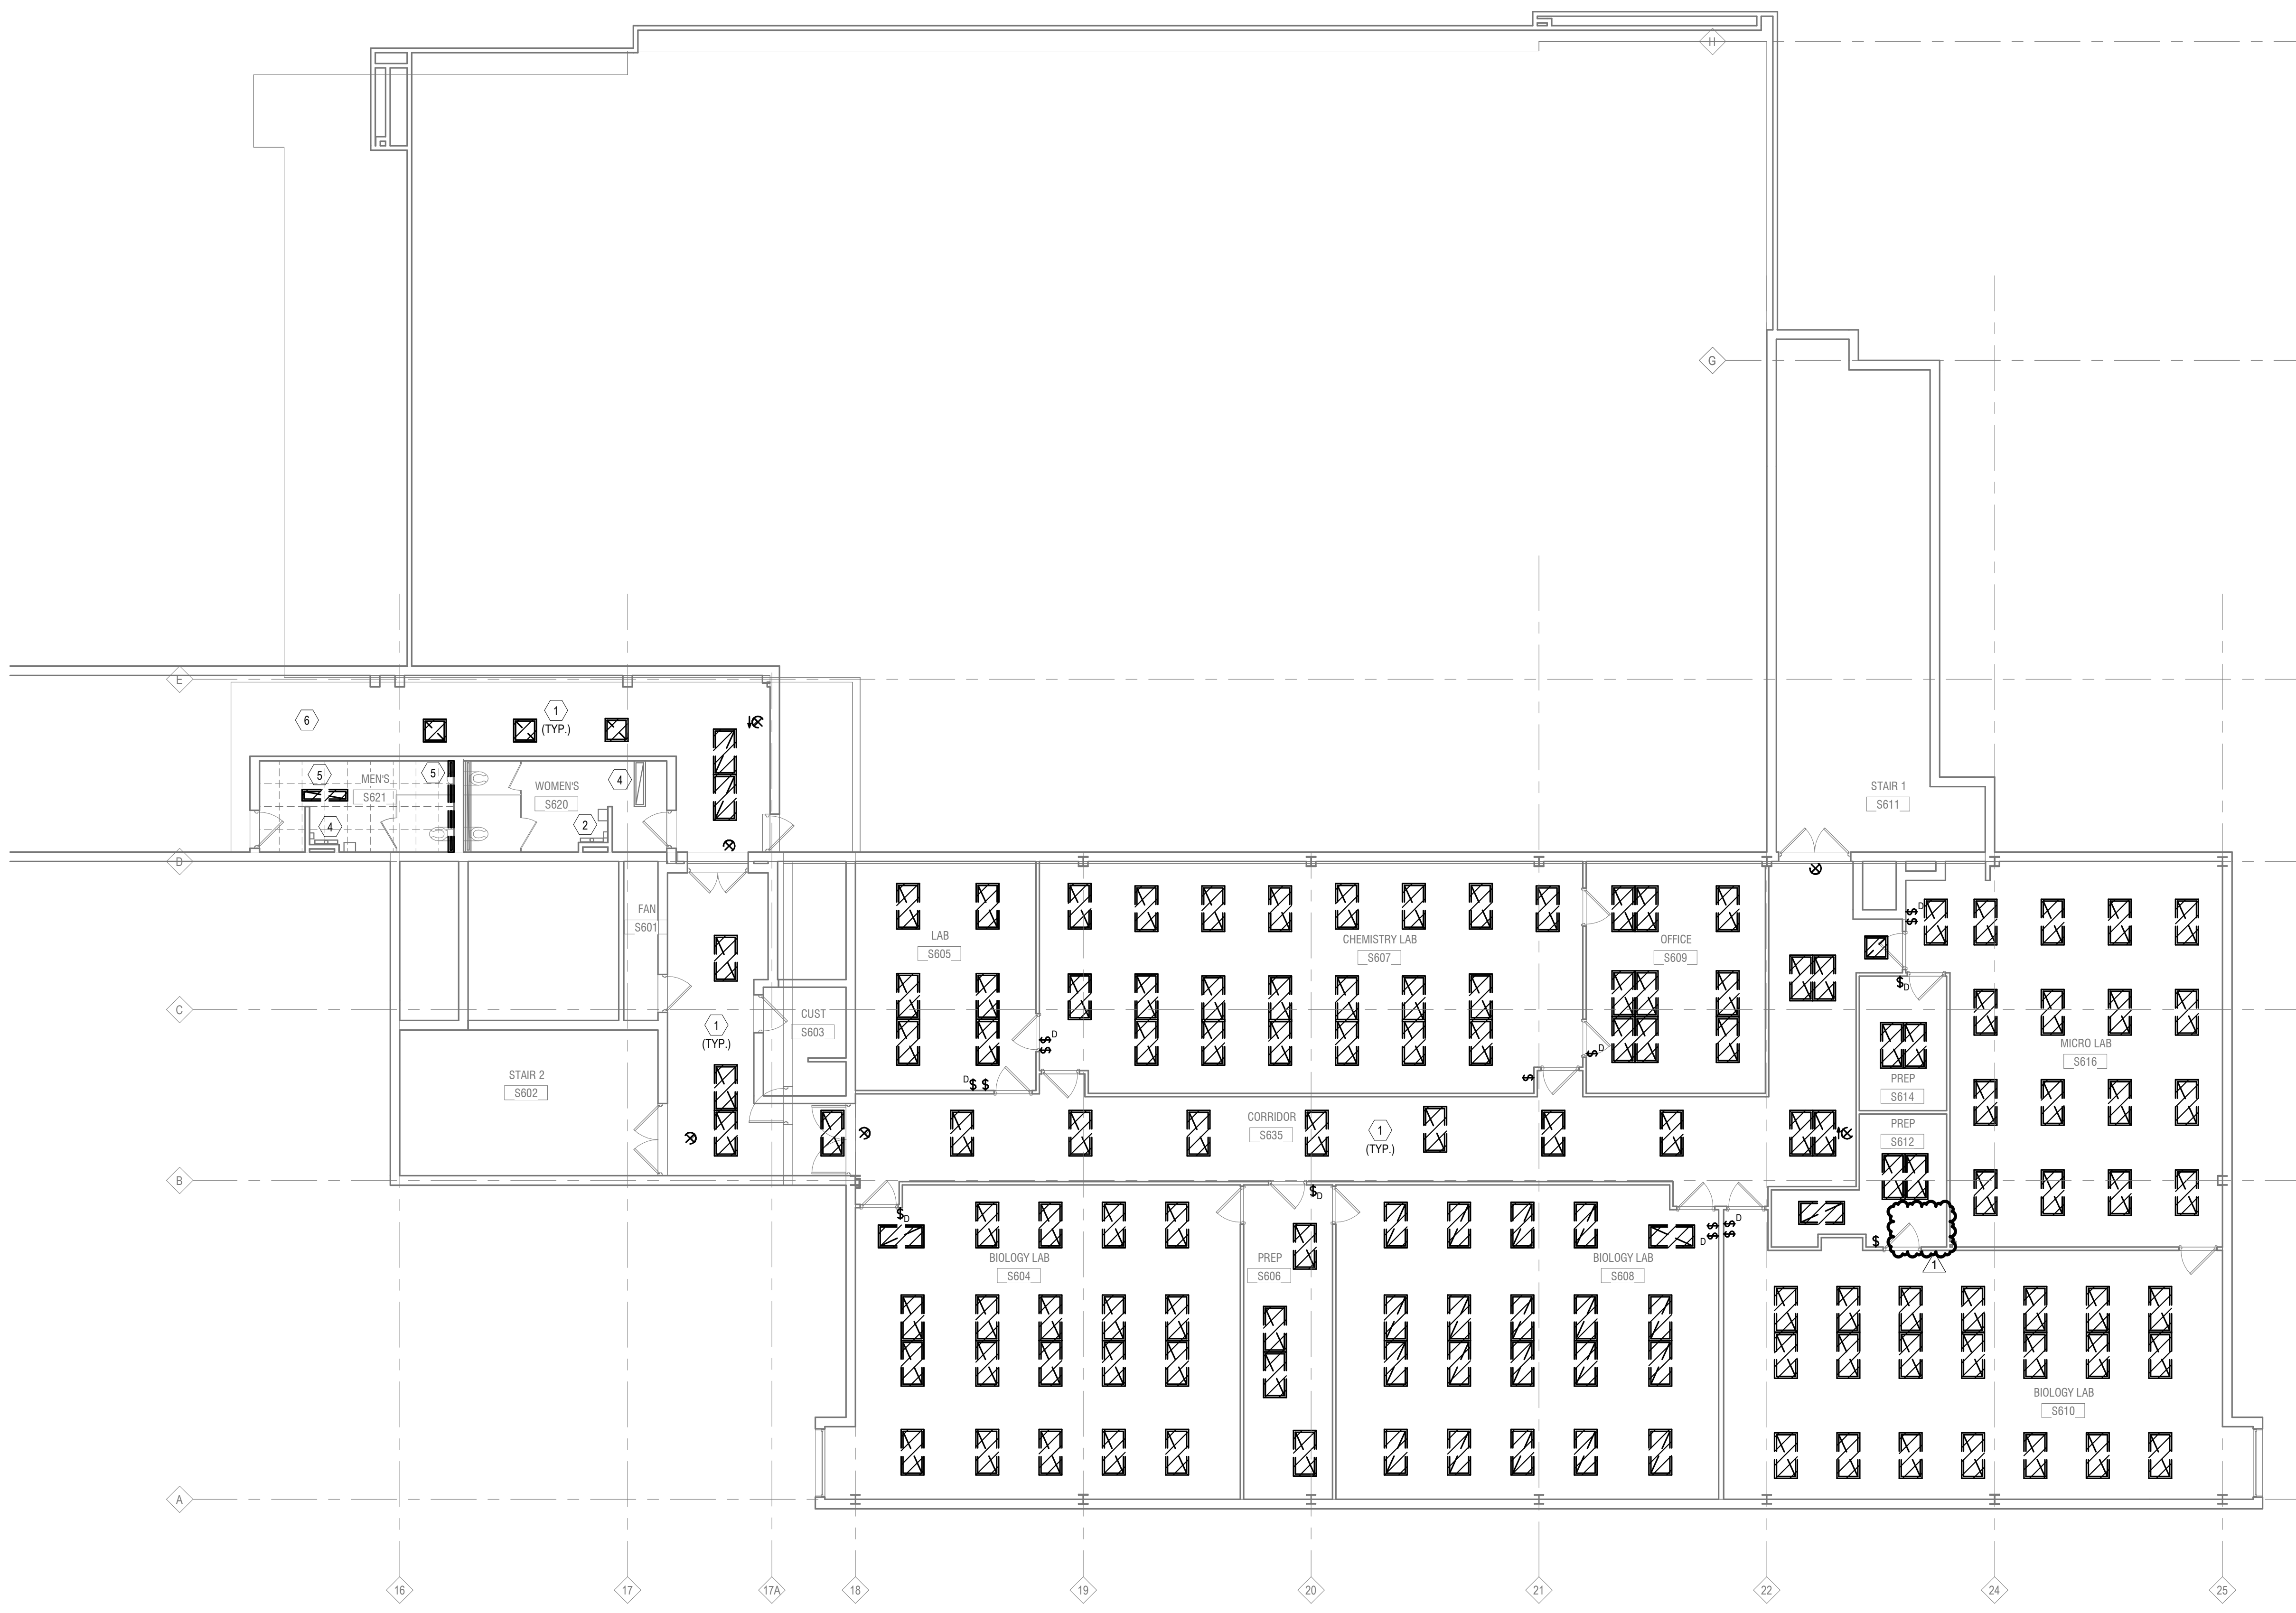

1 PARTIAL SIXTH FLOOR LIGHTING DEMOLITION PLAN  
1/8" = 1'-0"

**AE WORKS**  
418 BEAVER STREET  
SEWICKLEY, PA 15143  
PH: 412.287.7333  
www.aeworks.com

CLIENT:  
COMMUNITY COLLEGE  
OF ALLEGHENY COUNTY

595 Beatty Rd  
Monroeville, PA 15146

SUBMISSION:  
**BID DOCUMENTS**

NO	DATE	REVISION
1	5/13/2026	ADDENDUM 3

PROFESSIONAL:


PROJECT NAME:  
**CCAC BIOLOGY LAB  
RENOVATIONS BOYCE  
CAMPUS**

595 Beatty RD, Monroeville PA  
15146

DRAWING TITLE:  
**PARTIAL SIXTH FLOOR  
LIGHTING DEMOLITION  
PLAN**

DRAWN BY: JC  
CHECKED BY: DF  
PROJ. NO: CCAC-006  
DATE: 04.14.2026  
DRAWING NO: **ED101**

Atodesk Docs://CCAC-006 Boyce Bio Lab/CCAC-006\_MEP\_24.rvt  
5/13/2026 4:23:39 PM

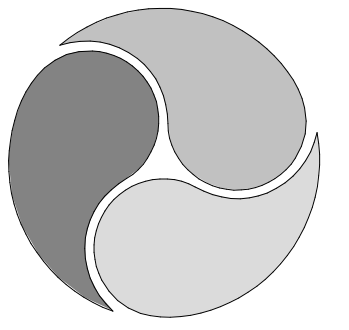

**AE WORKS**

418 BEAVER STREET  
SEWICKLEY, PA 15143  
PH: 412.287.7333  
www.aeworks.com


CLIENT:  
COMMUNITY COLLEGE  
OF ALLEGHENY COUNTY

**ELECTRICAL DEMOLITION GENERAL NOTES**


- UNLESS NOTED OTHERWISE, REMOVE ALL ELECTRICAL DEVICES FROM WITHIN THE AREA OF DEMOLITION WORK IDENTIFIED. THE DEVICES TO BE REMOVED SHALL INCLUDE BUT ARE NOT LIMITED TO: RECEPTACLES, FIRE ALARM DEVICES AND TERMINAL CABINETS, SWITCHES, JUNCTION BOXES, LIGHTS, LIGHTING CONTROLS, PANELBOARDS AND FLOOR BOXES. REMOVE ALL ASSOCIATED CONDUIT AND WIRE BACK TO THE UPSTREAM DISTRIBUTION DEVICE. THE INTENT IS FOR ALL DEVICES TO BE REMOVED TO ALLOW THE RENOVATION AND INSTALLATION OF ALL NEW DEVICES AS SHOWN ON THE NEW WORK DOCUMENTS. EXISTING DEVICES SHOWN ARE DIAGRAMMATIC AND BASED ON FIELD SURVEYS AND/OR RECORD DRAWINGS PROVIDED BY THE OWNER AND DO NOT REPRESENT THE FULL SCOPE OF DEMOLITION WORK. THE ACTUAL CONDITIONS MAY VARY. ALL EXISTING CONDITIONS MUST BE VERIFIED PRIOR TO BID. THE PLANS ARE INTENDED TO SHOW THE LOCATIONS OF EXISTING DEVICES AND IN NO WAY RELIEVE THE CONTRACTOR FROM PROVIDING ANY AND ALL COORDINATION NECESSARY TO COMPLETE THE NEW WORK. FIELD CONDITIONS SHALL GOVERN. FIELD VERIFY ALL EXISTING CONDITIONS AND DIMENSIONS PRIOR TO COMMENCEMENT OF WORK AND OBTAIN CLARIFICATIONS FROM ARCHITECT/ENGINEER IF NECESSARY. COMPONENTS RELATED TO THE EXISTING BUILDING-WIDE LIGHTING CONTROL SYSTEM SHALL BE RETAINED AND REUSED WHERE FEASIBLE WITH NEW LIGHTING AND CONTROL DEVICES.
- CONTRACTOR SHALL PROVIDE A MINIMUM TWO WEEKS WRITTEN NOTICE PRIOR TO ANY SHUT DOWN. NOTICE IS TO INCLUDE BUT IS NOT LIMITED TO THE LOCATION, PANELS AND DURATION OF SHUT DOWN.
- OWNER SHALL HAVE RIGHT OF FIRST REFUSAL TO ANY EQUIPMENT, DEVICES, LUMINAIRES, ETC. DEMOLISHED FROM RENOVATION AREA PRIOR TO DISPOSAL.
- MAINTAIN CONTINUITY OF SERVICE TO AREAS OUTSIDE THE PROJECT BOUNDARY. PATCH AND REPAIR ALL CIRCUITS CUT OFF DURING DEMOLITION BY WIRING METHODS COMPATIBLE WITH THE EXISTING INSTALLATION.
- THE ELECTRICAL CONTRACTOR SHALL REVIEW THE DRAWINGS OF ALL OTHER TRADES IN THIS CONTRACT. THE REMOVAL OF ELECTRICAL SERVICE TO ALL EQUIPMENT IDENTIFIED ON OTHER TRADE DRAWINGS IS THE RESPONSIBILITY OF THE ELECTRICAL CONTRACTOR.
- EXERCISE EXTREME CAUTION WHEN REMOVING/RELOCATING WIRING AND EQUIPMENT. IT IS THE CONTRACTOR'S RESPONSIBILITY TO ENSURE THAT OTHER WIRING DEVICES, EQUIPMENT AND LIGHT FIXTURES THAT MAY BE CONNECTED TO THE SAME CIRCUIT REMAIN OPERATIONAL AND ACTIVE.
- CONTRACTOR SHALL EXAMINE CONDITIONS AND TEST FUNCTIONALITIES OF ALL EXISTING ELECTRICAL EQUIPMENT IDENTIFIED TO BE REUSED AND/OR RELOCATED. PROVIDE REPORT TO ENGINEER AND OWNER PRIOR TO DEMOLITION.
- NOT APPLICABLE
- NOT APPLICABLE
- NOT APPLICABLE

**ELECTRICAL DEMOLITION KEYNOTES**

- ALL WIRES, CONDUITS, AND DISCONNECTS ASSOCIATED WITH DEMOLISHED MECHANICAL EQUIPMENT SHALL BE REMOVED BACK TO THEIR SOURCE.

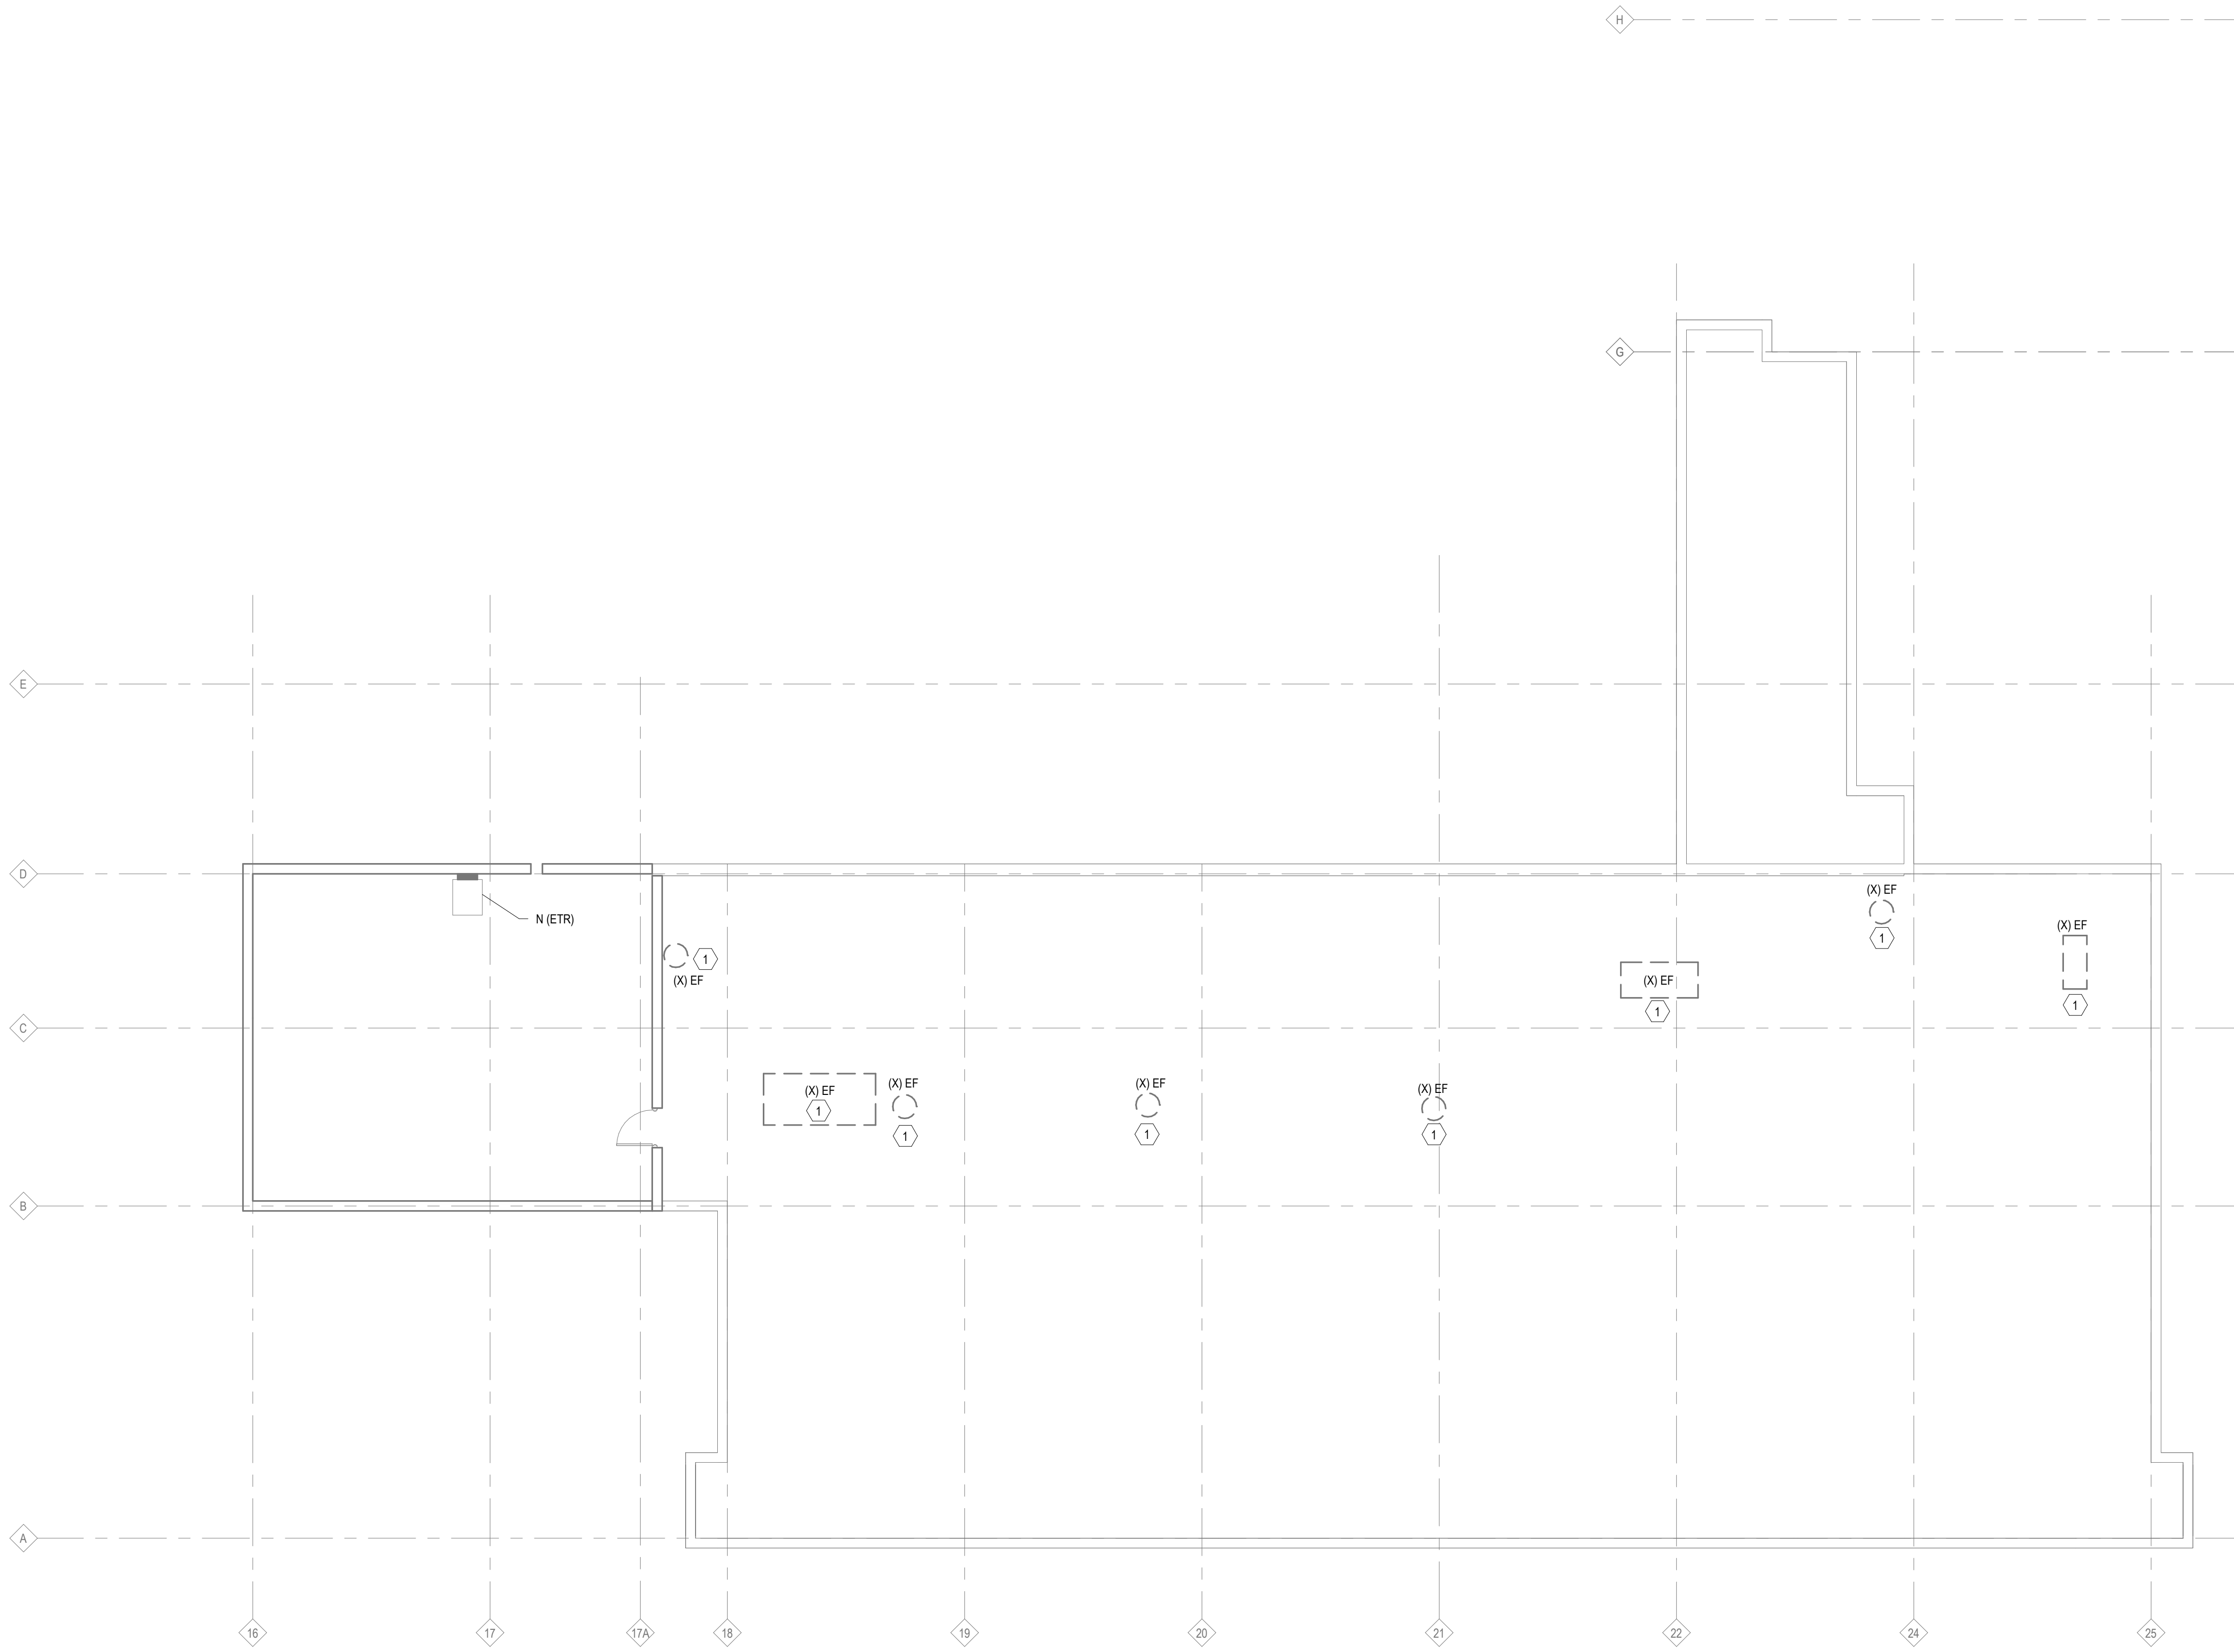

**1 ELECTRICAL ROOF DEMOLITION PLAN**  
1/8" = 1'-0"

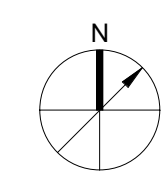

DRAWN BY: JC  
CHECKED BY: DF  
PROJ. NO: CCAC-008  
DATE: 04.14.2026  
DRAWING NO:

**ED103**

COPYRIGHT 2020 BY AE WORKS LTD ALL RIGHTS RESERVED.

595 Beatty Rd  
Monroeville, PA 15146

SUBMISSION:  
**BID DOCUMENTS**

NO	DATE	REVISION
1	5/13/2026	ADDENDUM 3

PROFESSIONAL:

PROJECT NAME:  
**CCAC BIOLOGY LAB  
RENOVATIONS BOYCE  
CAMPUS**

595 Beatty RD, Monroeville PA  
15146

DRAWING TITLE:  
**ELECTRICAL ROOF  
DEMOLITION PLAN**

E

D

C

B

A

Atodesk Docs://CCAC-008\_Boyce\_Bio\_Lab/CCAC-008\_MEP\_24.rvt  
5/13/2026 4:28:42 PM


SPACE TYPE	LIGHTING CONTROL SEQUENCE OF OPERATION													
	NORMAL BUSINESS HOURS OPERATION OCCUPIED				AFTER HOURS OPERATION OCCUPIED				EMERGENCY LIGHTING CONTROL	MANUAL CONTROL METHOD	BAS DRY CONTACT	UPON FIRE ALARM	COLOR TUNABLE	REMARKS
	ON ENTRY	MIN MANUAL	ACTION	DELAY	ON ENTRY	MIN MANUAL	ACTION	DELAY						
CORRIDORS (NORMAL LIGHTING)	FULL ON	NA	25%	5 MIN	FULL ON	NA	OFF	20 MIN	ALWAYS ON	NA	NO	FULL ON	NO	EXTEND BUSINESS HOURS WHEN ANY OCCUPANCY IS DETECTED IN BUILDING.
LAB	50%	SFC	OFF	20 MIN	50%	SFC	OFF	20 MIN	CONTROLLED	DIMMER	YES	FULL ON	NO	EXTEND BUSINESS HOURS WHEN ANY OCCUPANCY IS DETECTED IN BUILDING.
SINGLE OCCUPANT TOILET / WASHROOM	FULL ON	NA	OFF	10 MIN	FULL ON	NA	OFF	10 MIN	NA	SWITCH	NO	NA	NO	
PREP	50%	SFC	OFF	20 MIN	50%	NA	OFF	20 MIN	ALWAYS ON	DIMMER	YES	NA	NO	
OFFICE	50%	NA	OFF	20 MIN	50%	NA	OFF	20 MIN	CONTROLLED	DIMMER	NO	FULL ON	NO	
STUDENT LOUNGE	50%	SFC	OFF	10 MIN	50%	SFC	OFF	10 MIN	ALWAYS ON	DIMMER	NO	NA	NO	

LIGHTING PLAN GENERAL NOTES

- ALL EXIT SIGNS SHALL BE POWERED FROM THE CIRCUIT INDICATED AND UNSWITCHED.
- EMERGENCY BATTERY BALLASTS AND EMERGENCY BATTERY PACK UNITS SHALL BE CIRCUITED FROM THE CIRCUIT INDICATED.
- ALL EMERGENCY LIGHTING FIXTURES SHALL BE PROVIDED WITH A LISTED AUTOMATIC LOAD CONTROL RELAY TO PERMIT LOCAL CONTROL WITH ADJACENT FIXTURES AND BY-PASS OF LOCAL CONTROL (INCLUDING BUT NOT LIMITED TO SWITCHES, OCCUPANCY SENSORS AND DIMMERS) IN THE ABSENCE OF NORMAL POWER. UPON LOSS OF NORMAL POWER, THE LIGHTING CONTROL SHALL BE BY-PASSED, AND DIMMED FIXTURES SHALL COME TO FULL ILLUMINATION AND SHALL NOT BE ALLOWED TO TURN OFF. REFER TO TYPICAL DETAIL.
- COORDINATE FINAL LOCATIONS OF FIXTURES WITH THE REFLECTED CEILING PLAN. ANY CONFLICTS SHALL BE BROUGHT TO THE ATTENTION OF THE ARCHITECT AND ENGINEER.
- COORDINATE ALL MOUNTING HEIGHTS WITH THE ARCHITECT AND ENGINEER PRIOR TO ROUGH-IN.
- WHERE MORE THAN ONE SWITCH OCCURS IN THE SAME LOCATION, THEY SHALL BE INSTALLED IN GANG TYPE BOX UNDER THE COVERPLATE. MINIMUM CONDUIT SIZE IS 3/4" AND MINIMUM WIRE SIZE SHALL BE #12 AWG. ALL WIRE TO BE STRANDED COPPER.
- THE OCCUPANCY SENSORS INDICATED ON THE DRAWINGS ARE SHOWN FOR DESIGN INTENT ONLY. THE EXACT QUANTITY OF SENSORS SHALL BE DETERMINED BY THE ELECTRICAL CONTRACTOR PRIOR TO INSTALLING SENSORS BASED ON THE MANUFACTURER'S RECOMMENDATION. PROVIDE 100% COVERAGE OF EACH INDIVIDUAL ROOMSPACE SHOWN ON THE DRAWINGS. DO NOT INSTALL SENSORS PRIOR TO SUBMITTING COVERAGE LAYOUTS FOR EACH INDIVIDUAL ROOMSPACE TO THE ENGINEER FOR APPROVAL. DO NOT INSTALL SENSORS SUCH THAT THEY CAN POTENTIALLY "SEE" THROUGH OPEN DOORWAYS. INSTALL ALL LOW VOLTAGE POWER PACKS DIRECTLY ABOVE LOCAL WALL SWITCHES IN THE AREA. DO NOT INSTALL ULTRASONIC OR DUAL TECHNOLOGY SENSORS WITHIN 24" OF SUPPLY DIFFUSERS.
- ALL EMERGENCY EGRESS ILLUMINATION SHALL BE AVERAGE 1FC AND A MINIMUM OF 0.1FC FOR PATH OF EGRESS.
- PROVIDE CONDUIT AND WIRING AS REQUIRED TO MEET CIRCUITING SHOWN TO CONFORM TO NEC REQUIREMENTS. PROVIDE EQUIPMENT GROUND CONDUCTOR IN ALL RACEWAYS. REFER TO PANELBOARD SCHEDULES.
- ROUTE CONDUIT HIGH AGAINST STRUCTURE AND OFFSET UP BETWEEN JOISTS WHERE NECESSARY TO AVOID DUCT WORK AND HVAC SYSTEM.

LIGHTING PLAN KEYNOTES

- NOT USED.
- NOT USED.
- CEILING MOUNTED OCCUPANCY SENSORS WITHIN LABS SHALL BE TIED INTO BUILDING BMS SYSTEM TO ALSO CONTROL LAB AIR CHANGE RATES.
- EXISTING LIGHTING IN THIS AREA IS EXISTING TO REMAIN.
- ALL LIGHT FIXTURES AND ASSOCIATED LIGHTING CONTROL DEVICES IN THIS SPACE TO BE CONNECTED TO EXISTING WATSTOPPER PLUS NETWORK LIGHTING CONTROL SYSTEM EXISTING IN THE BUILDING. PROVIDE SENSORS, CONTROL DEVICES AND LED DRIVERS COMPATIBLE WITH THIS SYSTEM, INCLUDING ADDITIONAL COMPONENTS SUCH AS LIGHTING CONTROLLERS, LUMINAIRE CONTROL MODULES, SENSOR INTERFACE MODULES, ETC TO MEET CONTROL INTENT INDICATED ON PLANS WHILE ALSO INTERFACING WITH EXISTING BUILDING-WIDE SYSTEM. PROVIDE CONTROL WIRING BETWEEN FIXTURES, DEVICES, CONTROLLERS AND CENTRAL SYSTEM PER MANUFACTURER REQUIREMENTS (I.E. DO NOT UTILIZE WIRELESS SENSORS OR DEVICES). CONFIRM WITH MANUFACTURER WHETHER ANY ADDITIONAL EXPANSION UNITS ARE NEEDED WITH THE EXISTING BUILDING SYSTEM TO ENABLE ADDITION OF THESE SPACES AND CONTROL POINTS, INCLUDING ADDITIONAL SYSTEM SUPPORT UNITS AND ETHERNET SWITCHES. INSTALLED SYSTEM TO BE PROGRAMMED TO PROVIDE LIGHTING CONTROL INTENT INDICATED ON ELECTRICAL DRAWINGS.
- PROVIDE AREA LIGHTING CONTROLLER PER WATSTOPPER PLUS RISER ON SHEET E02 FOR CONNECTION DETAILS.

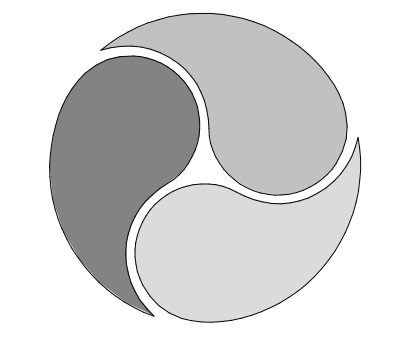

AE WORKS

418 BEAVER STREET  
SEWICKLEY, PA 15143  
PH: 412.287.7333  
www.aeworks.com

CLIENT:  
COMMUNITY COLLEGE  
OF ALLEGHENY COUNTY

595 Beatty Rd  
Monroeville, PA 15146

SUBMISSION:  
BID DOCUMENTS

NO	DATE	REVISION
1	5/13/2026	ADDENDUM 3

PROFESSIONAL:

PROJECT NAME:  
CCAC BIOLOGY LAB  
RENOVATIONS BOYCE  
CAMPUS

595 Beatty RD, Monroeville PA  
15146

DRAWING TITLE:  
PARTIAL SIXTH FLOOR  
LIGHTING PLAN

DRAWN BY: JC  
CHECKED BY: DF  
PROJ. NO: CCAC-006  
DATE: 04/14/2026  
DRAWING NO:

E101

COPYRIGHT 2020 BY AE WORKS LTD ALL RIGHTS RESERVED.


E

D

C

B

A

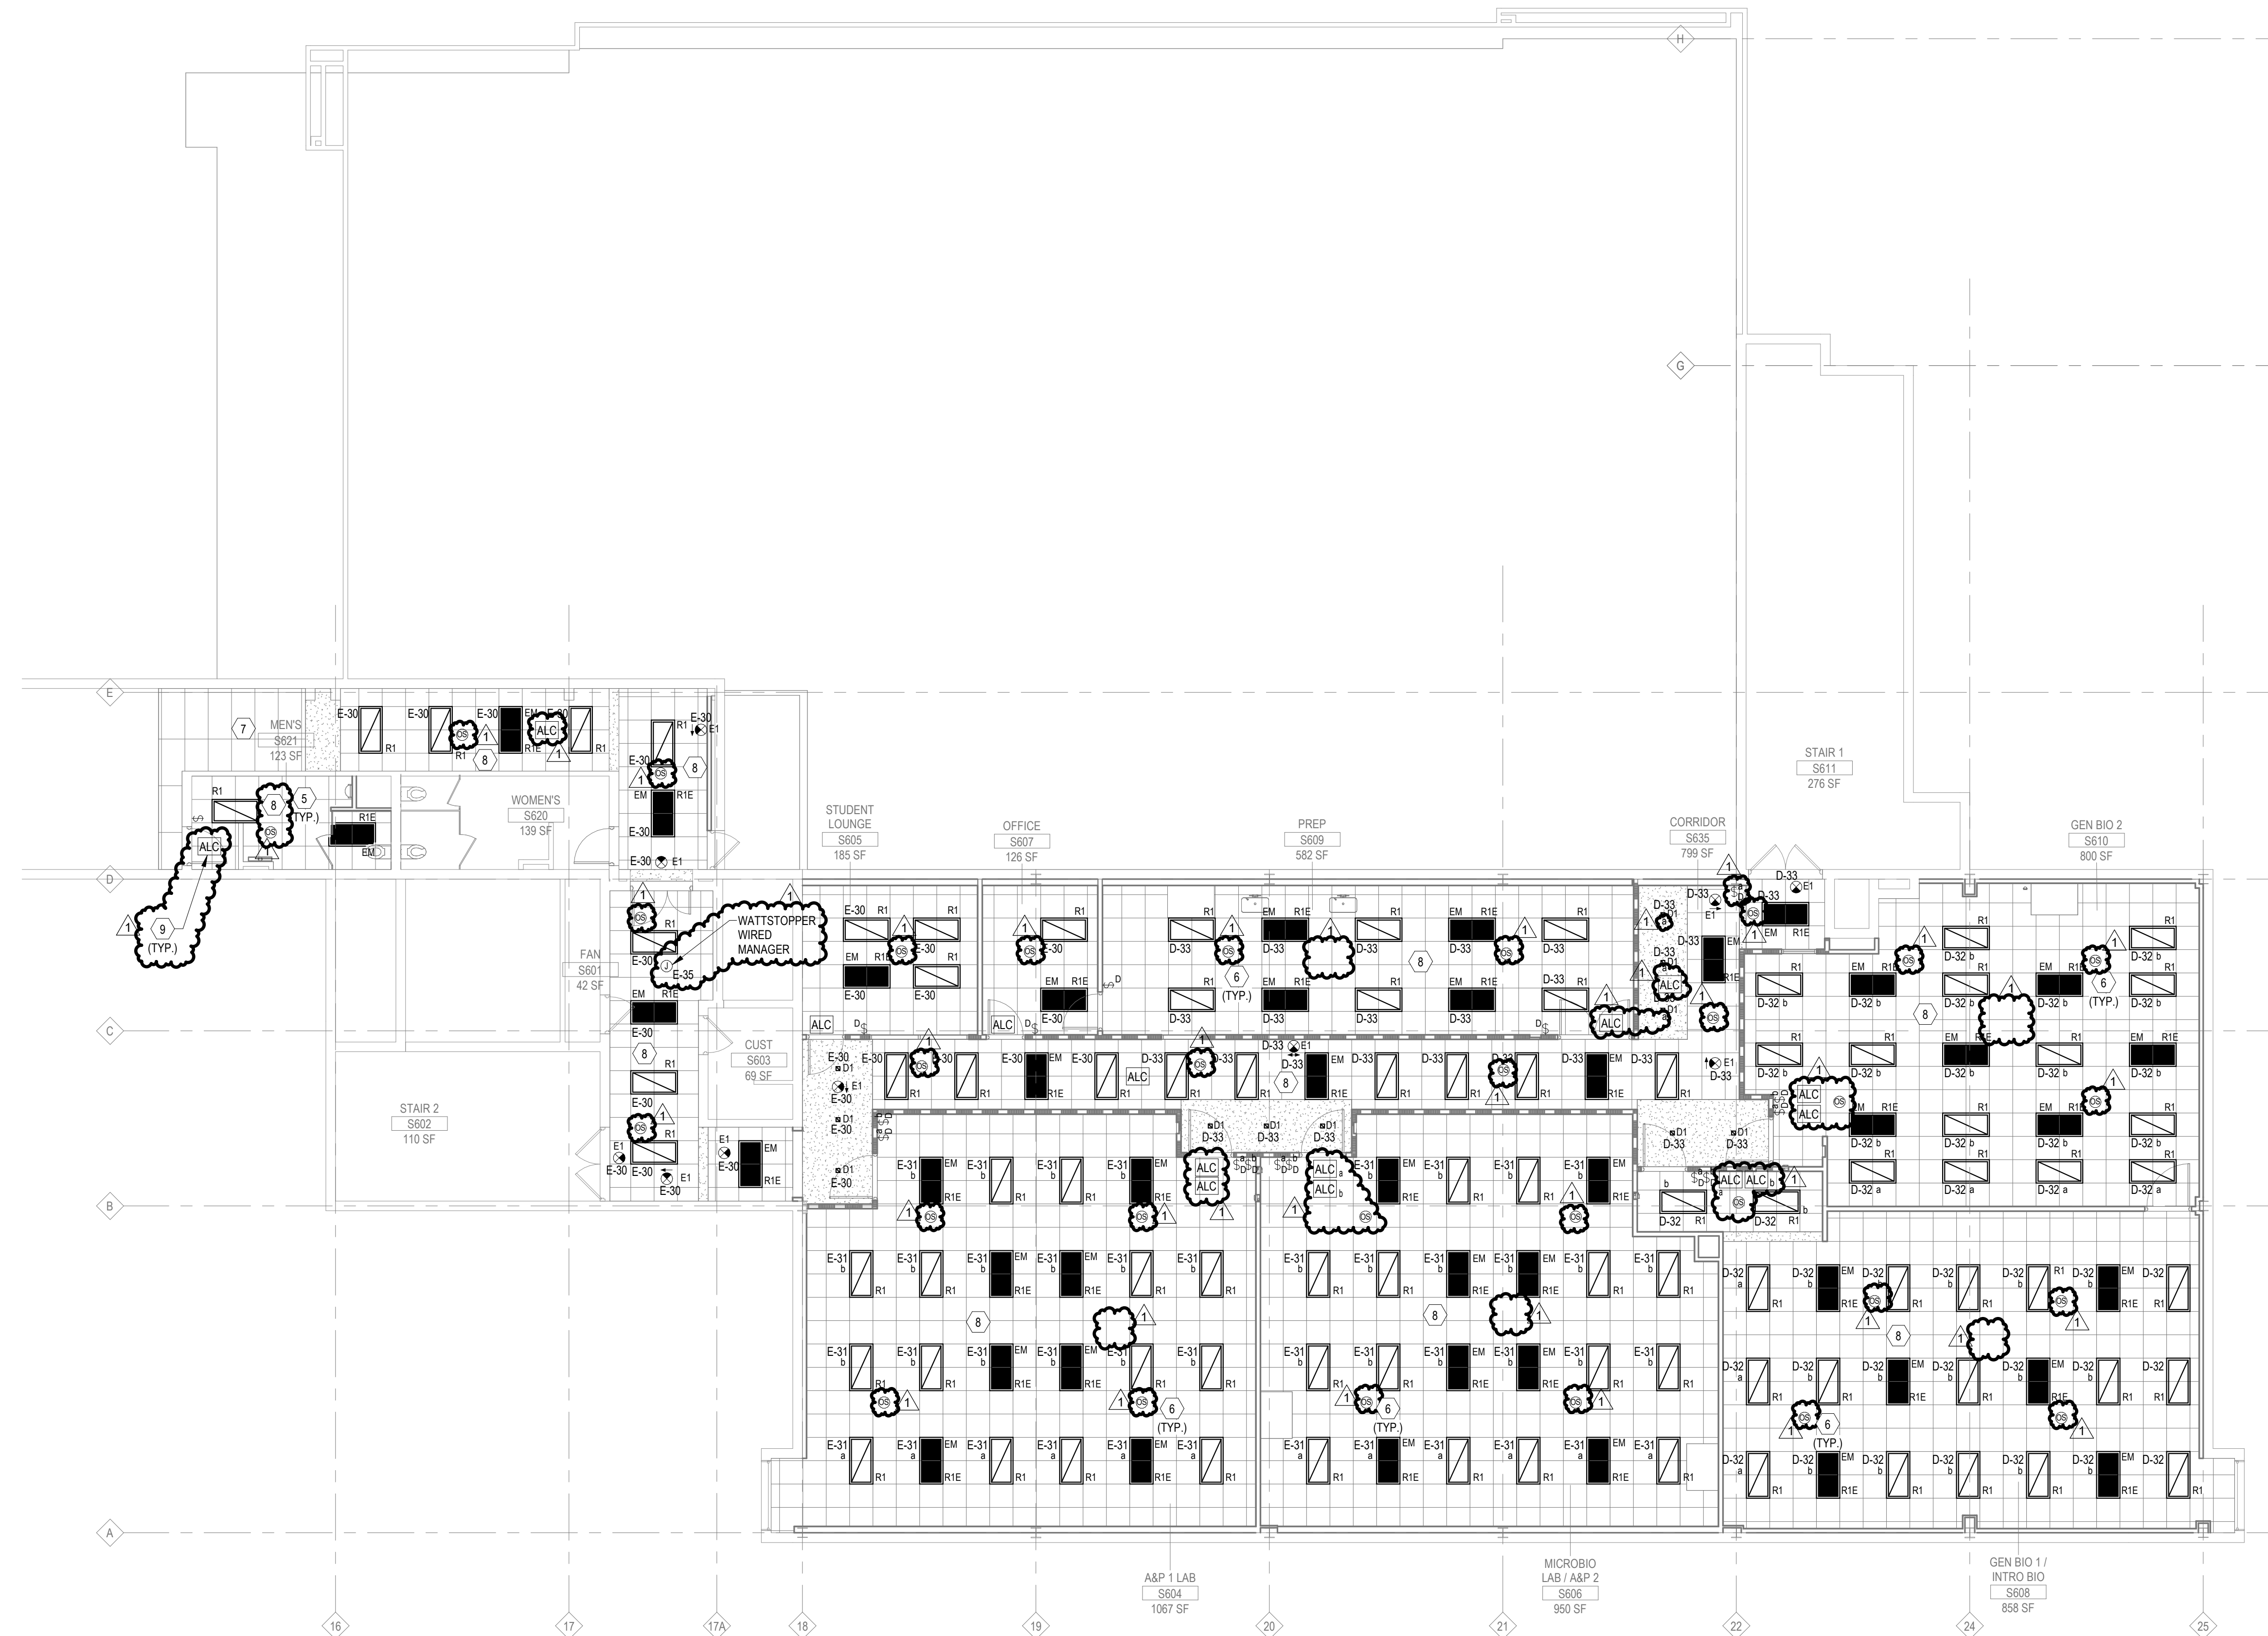

1 PARTIAL SIXTH FLOOR LIGHTING PLAN  
1/8" = 1'-0"

Atodesk Docs://CCAC-006 Boyce Bio Lab/CCAC-006\_MEP\_24.rvt  
5/13/2026 4:29:42 PM

**GENERAL NOTES - UNDERFLOOR WORK**

- CONTRACTOR SHALL PROVIDE A PHASING PLAN OF ALL WORK AREAS FOR REVIEW BY THE OWNER PRIOR TO CEILING REMOVAL. OBTAIN WRITTEN APPROVAL FROM OWNER PRIOR TO START OF WORK.
- CONTRACTOR SHALL PROVIDE DUST CONTAINMENT ENCLOSURE AT EACH PHASE OF WORK.
- COORDINATE WORK WITH ALL PRIME CONTRACTORS TO OCCUR OVER SUMMER AND HOLIDAY BREAKS AND WEEKENDS TO MINIMIZE DISRUPTION TO STUDENT SERVICES.

**ADD ALTERNATE**


PROVIDE WALL MOUNTED KEY SWITCH ADJACENT TO THE ROOM LIGHTING CONTROL IN ALL LAB SPACES. THE KEY SWITCH IS TO ALLOW MANUAL (ON/OFF) CONTROL OF RECEPTACLE POWER IN THAT SPACE. CONTRACTOR IS TO PROVIDE A SHUNT-TRIP BREAKER FOR EACH RECEPTACLE CIRCUIT AT THE BRANCH PANELBOARD.

**POWER PLAN GENERAL NOTES**

- FINAL LOCATION OF ALL EQUIPMENT SHALL BE DETERMINED IN THE FIELD AND SHALL BE INSTALLED AS DIRECTED BY THE ARCHITECT OR OWNER'S REPRESENTATIVE. WHERE STRUCTURAL OPENINGS ARE NOT AVAILABLE, THE CONTRACTOR SHALL CORE DRILL WALLS AND FLOORS AS REQUIRED TO PERMIT PASSAGE OF CONDUITS. THE ELECTRICAL CONTRACTOR SHALL PROVIDE A MARKED-UP PLAN WITH LOCATION PENETRATIONS FOR REVIEW AND APPROVAL OF THE STRUCTURAL ENGINEER BEFORE ROUGH-IN BEGINS.
- DURING THE BIDDING PROCESS, THE ELECTRICAL CONTRACTOR SHALL REVIEW DRAWINGS AND SPECIFICATIONS OF ALL OTHER TRADES (ARCHITECTURAL, SITESLANDSCAPING, HVAC, PLUMBING AND SPECIALTY TRADES). ALL ITEMS REQUIRING POWER INDICATED ON THESE DRAWINGS BUT NOT INDICATED ON THE ELECTRICAL DRAWINGS SHALL BE CONSIDERED A PART OF THE ELECTRICAL CONTRACTOR'S WORK. THIS WORK SHALL BE INSTALLED AS PER NEC REQUIREMENTS AT NO ADDITIONAL COST TO THE OWNER.
- THE CONTRACTOR SHALL MAKE EVERY EFFORT TO MAKE ALL FEEDER RUNS CONTINUOUS (NO CABLE BREAKS). IF SPLICING CABLES IN BOXES BECOMES NECESSARY, USE O.Z.G. TYPE "XW" CABLE TAPS, OR APPROVED EQUAL, AND TAPE EACH TAP IN APPROVED MANNER.
- THE MECHANICAL CONTRACTOR SHALL PROVIDE DISCONNECT SWITCHES, VFDs, OR COMBINATION STARTERS FOR ALL OF THEIR UNITS. THE ELECTRICAL CONTRACTOR SHALL RECEIVE THESE ITEMS FROM THE MECHANICAL CONTRACTOR FOR INSTALLATION BY THE ELECTRICAL CONTRACTOR.
- THE ELECTRICAL CONTRACTOR SHALL COORDINATE CONDUIT PENETRATIONS FOR ROOFTOP EQUIPMENT WITH MECHANICAL AND ROOFING CONTRACTORS. IF PROVISIONS ARE NOT IN PLACE FOR THESE PENETRATIONS THE ELECTRICAL CONTRACTOR SHALL BE RESPONSIBLE FOR MAKING OWN PENETRATIONS AND CONTRACTING THE ROOF CONTRACTOR FOR SEALING THE ROOF PENETRATIONS.
- REFER TO MECHANICAL DRAWINGS FOR EXACT LOCATION OF ALL MECHANICAL EQUIPMENT. PROVIDE CONDUIT AND WIRING AS REQUIRED TO MEET CIRCUITING SHOWN TO CONFORM TO NEC REQUIREMENTS.
- PROVIDE EQUIPMENT GROUND CONDUCTOR IN ALL RACEWAYS. REFER TO PANELBOARD SCHEDULES.
- REFER TO EQUIPMENT CONNECTION SCHEDULE FOR ELECTRICAL REQUIREMENTS AND CIRCUIT DESIGNATIONS.
- ROUTE CONDUIT HIGH AGAINST STRUCTURE AND OFFSET UP BETWEEN JOISTS WHERE NECESSARY TO AVOID DUCT WORK AND HVAC SYSTEM.
- VERIFY AND COORDINATE EXACT ELECTRICAL REQUIREMENTS OF ALL EQUIPMENT WITH MANUFACTURER'S RECOMMENDATIONS PRIOR TO INSTALLATION OF EQUIPMENT.
- CONTRACTOR SHALL LABEL ALL RECEPTACLES ON DEDICATED CIRCUITS AS "DEDICATED FOR EQUIPMENT".

**POWER PLAN KEYNOTES**

- JUNCTION BOXES IN FLOOR SHALL CONNECT TO MANUFACTURER POWER CONNECTION POINT IN LAB BENCHES. JUNCTION BOXES SHALL INCLUDE POKE THROUGH TO SUPPORT 3/4" CONDUIT AND NOT CONTAIN ANY RECEPTACLES. CONDUITS SHALL BE RUN IN CEILING OF THE FLOOR BELOW.
- JUNCTION BOX SHALL BE UTILIZED FOR POWER PULL TO PRESENTER DESK.
- RECEPTACLES SHALL BE MOUNTED IN BASE OF SEATING.
- RECEPTACLES SHALL BE MOUNTED IN CASEWORK.
- JUNCTION BOX FOR EMERGENCY GAS SHUTDOWN VALVE. COORDINATE EXACT LOCATION WITH PLUMBING DRAWINGS.

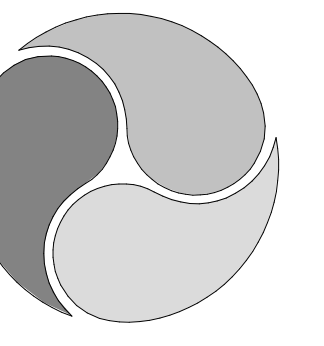

**AE WORKS**

418 BEAVER STREET  
SEWICKLEY, PA 15143  
PH: 412.287.7333  
www.aeworks.com

CLIENT:  
**COMMUNITY COLLEGE  
OF ALLEGHENY COUNTY**

595 Beatty Rd  
Monroeville, PA 15146

SUBMISSION:  
**BID DOCUMENTS**

NO	DATE	REVISION
1	5/13/2026	ADDENDUM 3

PROFESSIONAL:

PROJECT NAME:  
**CCAC BIOLOGY LAB  
RENOVATIONS BOYCE  
CAMPUS**

595 Beatty RD, Monroeville PA  
15146

DRAWING TITLE:  
**PARTIAL SIXTH FLOOR  
POWER PLAN**

DRAWN BY: JC  
CHECKED BY: DF  
PROJ. NO: CCAC-006  
DATE: 04/14/2026  
DRAWING NO:

**E201**

COPYRIGHT 2020 BY AE WORKS LTD ALL RIGHTS RESERVED.


E

D

C


B


A

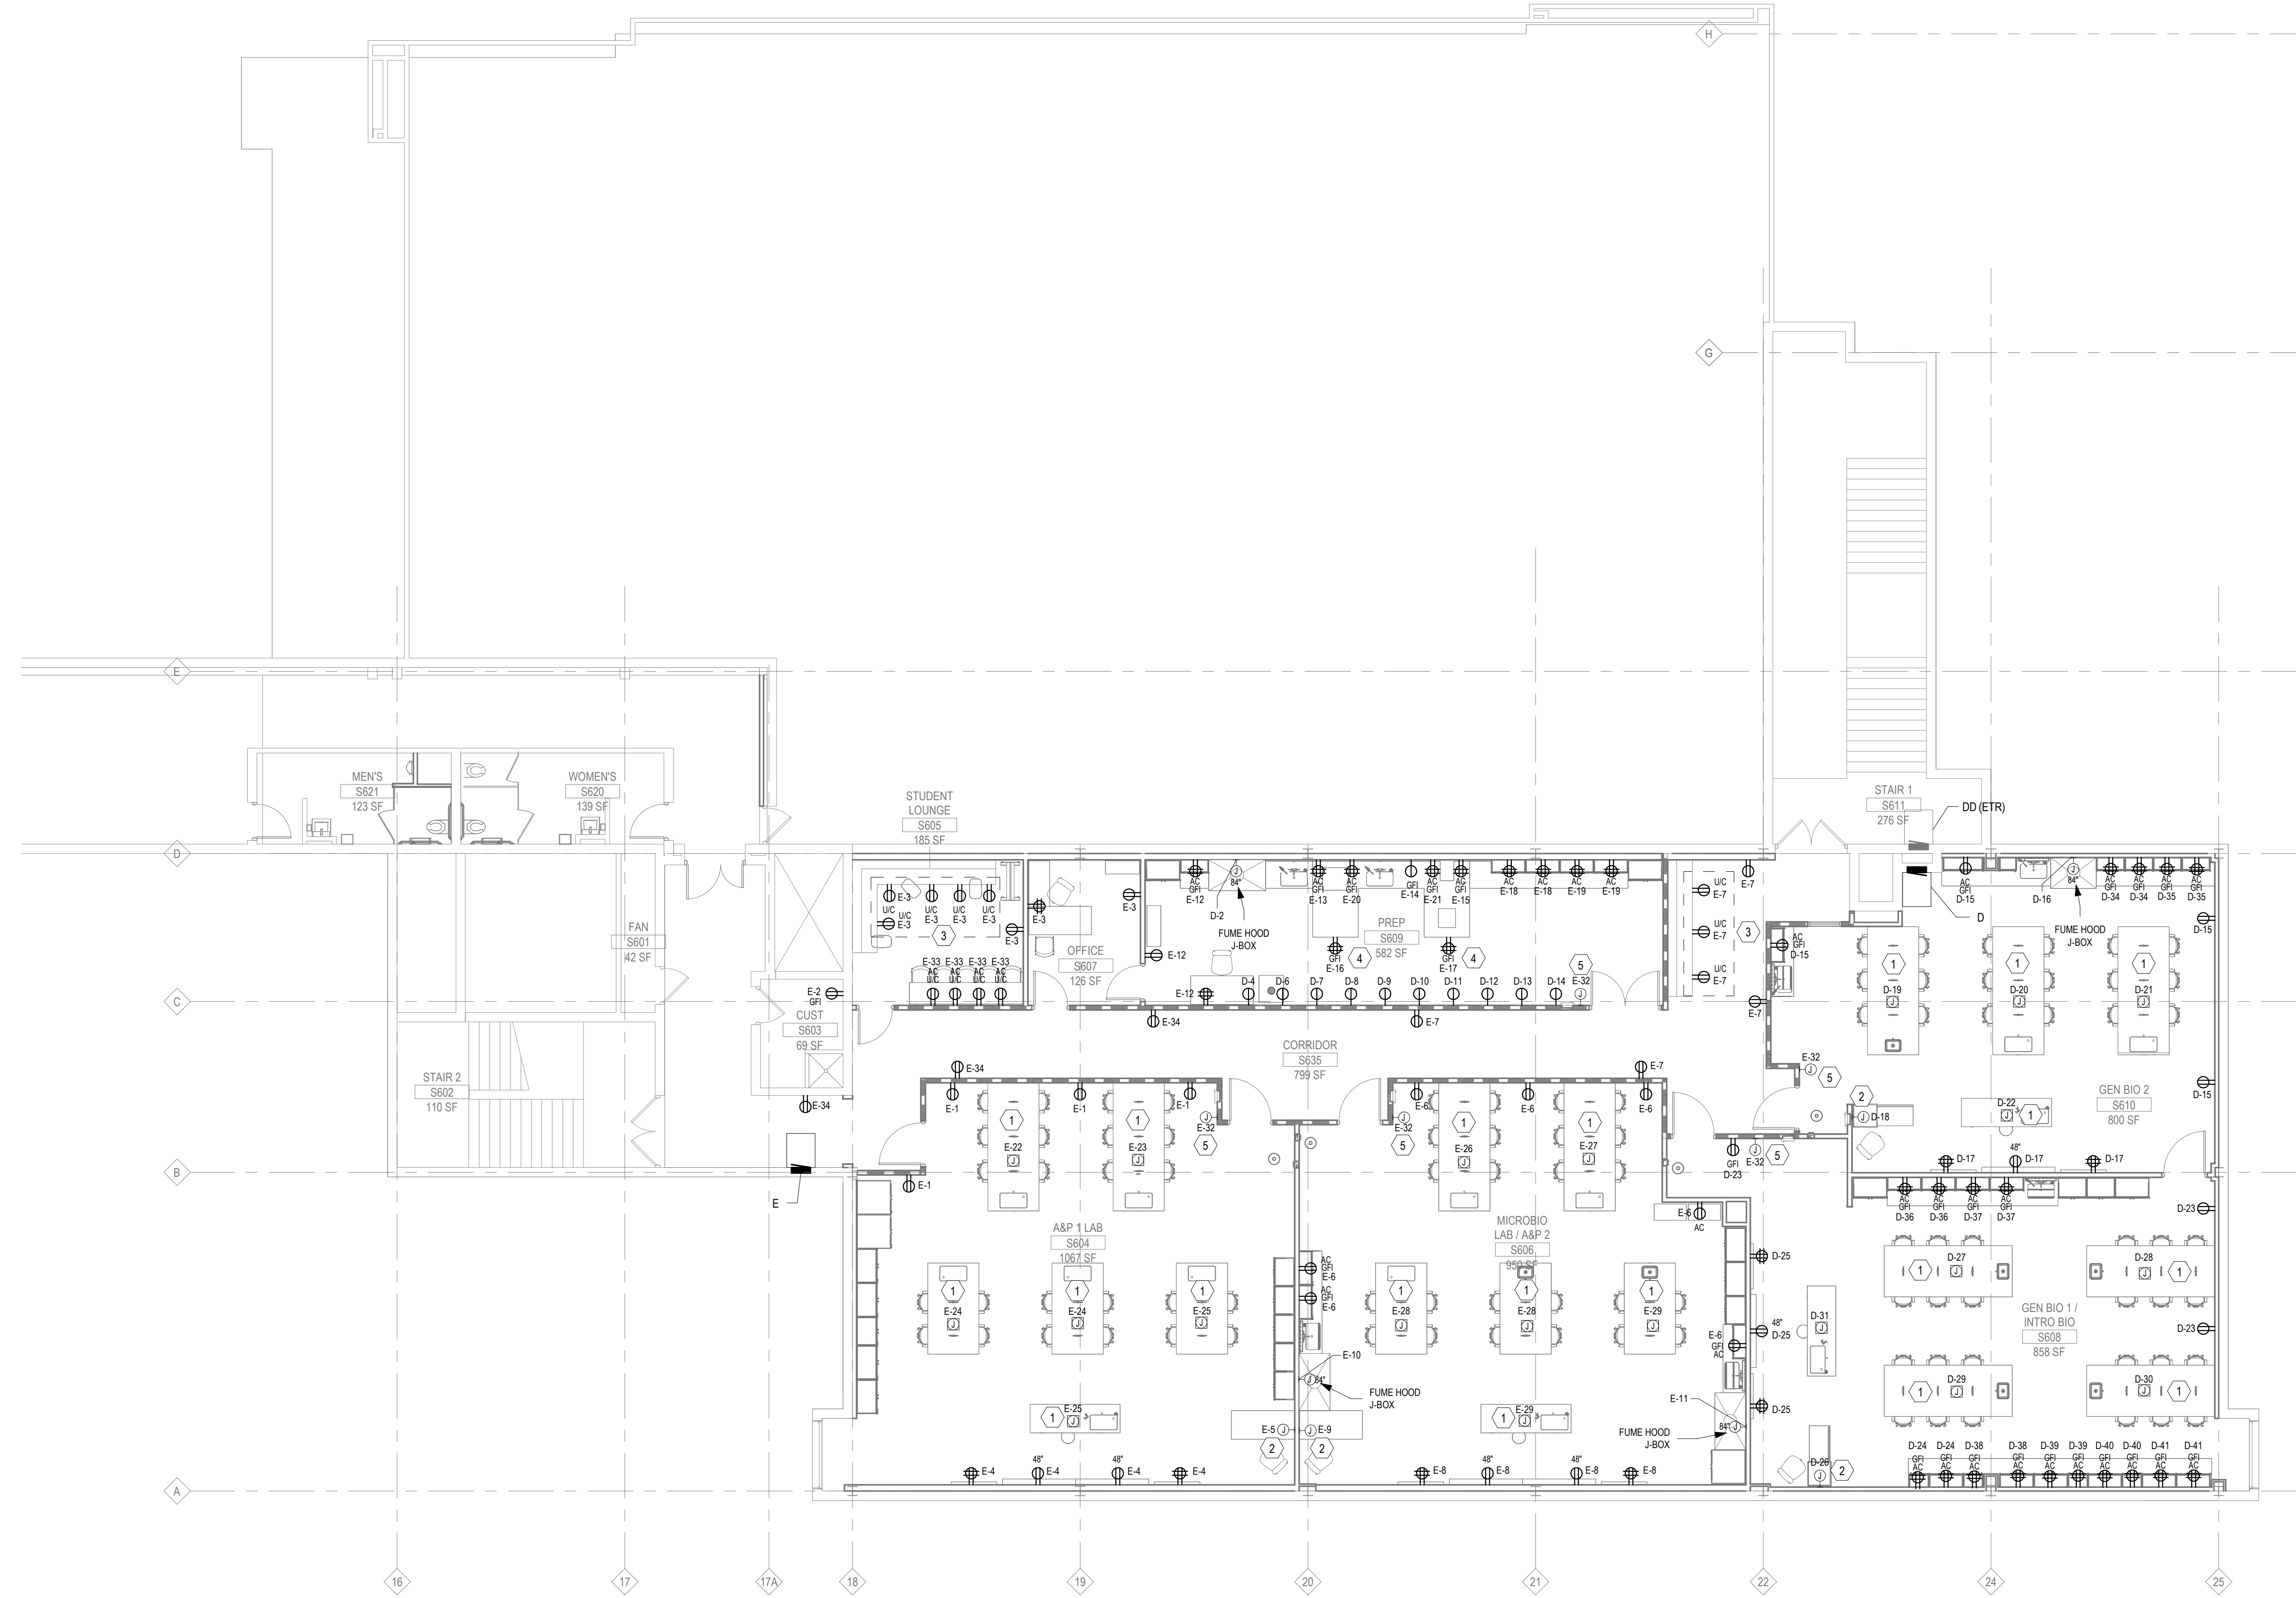

**1 PARTIAL SIXTH FLOOR POWER PLAN**  
1/8" = 1'-0"

Altodesk Docs://CCAC-006 Boyce Bio Lab/CCAC-006\_MEP\_24.rvt  
5/13/2026 4:23:55 PM

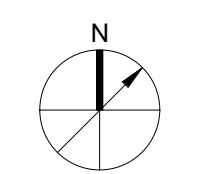

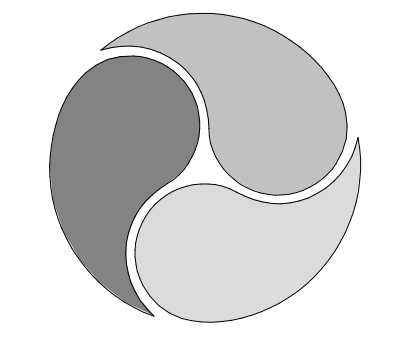

AE WORKS

418 BEAVER STREET SEWICKLEY, PA 15143 PH: 412.287.7333 www.aeworks.com

CLIENT: COMMUNITY COLLEGE OF ALLEGHENY COUNTY

595 Beatty Rd Monroeville, PA 15146

SUBMISSION: BID DOCUMENTS

Table with columns: NO, DATE, REVISION. Row 1: 1, 5/13/2026, ADDENDUM 3

PROFESSIONAL:

PROJECT NAME: CCAC BIOLOGY LAB RENOVATIONS BOYCE CAMPUS

595 Beatty RD, Monroeville PA 15146

DRAWING TITLE: ELECTRICAL SCHEDULES

DRAWN BY: JC CHECKED BY: DF PROJ. NO: CCAC-008 DATE: 04/14/2026 DRAWING NO:

E501

COPYRIGHT 2020 BY AE WORKS LTD ALL RIGHTS RESERVED.

PANEL D ELECTRICAL SCHEDULE. RATINGS: 208Y/120, 600 AMPS. LOCATION: CORRIDOR 610. Includes table with columns: CKT NO, CIRCUIT, BREAKER, LOAD (KVA), BREAKER, CIRCUIT, CKT NO.

NOTES: DEDICATED RECEPTACLES ARE INTENDED FOR LAB EQUIPMENT. EXACT LOCATION AND LOADS ARE NOT KNOWN. ENSURE RECEPTACLES CALLED "DEDICATED" ARE CIRCUITED AS SHOWN AS DRAWINGS.

ADD ALTERNATE: PROVIDE SHUNT-TRIP BREAKER FOR ALL RECEPTACLE CIRCUITS SERVING LAB 608, AND 610.

PANEL E ELECTRICAL SCHEDULE. RATINGS: 208Y/120, 150 AMPS. LOCATION: CORRIDOR 635. Includes table with columns: CKT NO, CIRCUIT, BREAKER, LOAD (KVA), BREAKER, CIRCUIT, CKT NO.

NOTES: DEDICATED RECEPTACLES ARE INTENDED FOR LAB EQUIPMENT. CONFIRM FINAL LOCATION OF RECEPTACLES WITH OWNER PRIOR TO INSTALL. ENSURE RECEPTACLES CALLED "DEDICATED" ARE ON THEIR OWN CIRCUIT.

ADD ALTERNATE: PROVIDE SHUNT-TRIP BREAKER FOR ALL RECEPTACLE CIRCUITS SERVING LAB 604, AND 606.

EXISTING PANEL DIST. PANEL #3 ELECTRICAL SCHEDULE. RATINGS: 208Y/120, 600 AMPS. LOCATION: ROOM 549. Includes table with columns: CKT NO, DESCRIPTION, BREAKER, LOAD (KVA), BREAKER, CIRCUIT, CKT NO.

NOTES: XFMR T-19 IS DE-ENERGIZED. THIS BREAKER SHALL NOT BE TURNED BACK ON TO ENSURE THE PANEL IS NOT OVERLOADED. THE MAIN FEEDER TO DIST. PANEL #3 IS TAPPED IN ROOM 418 TO FEED 100A PANEL CA.

EXISTING PANEL DIST. PANEL #2 ELECTRICAL SCHEDULE. RATINGS: 208Y/120, 1200 AMPS. LOCATION: ROOM 416. Includes table with columns: CKT NO, DESCRIPTION, BREAKER, LOAD (KVA), BREAKER, CIRCUIT, CKT NO.

NOTES: (1) - PANEL 'E' AND 'D' ARE TO BE REPLACED AS NOTED ON FLOOR PLANS. MAINTAIN EXISTING CONDUIT BUT RUN NEW FEEDERS TO BOTH PANELS. PANEL E BREAKER IS NEW AND PANEL D BREAKER IS ETR.

EXISTING PANEL DD ELECTRICAL SCHEDULE. RATINGS: 208Y/120, 100 AMPS. LOCATION: STAR 611. Includes table with columns: CKT NO, CIRCUIT, BREAKER, LOAD (KVA), BREAKER, CIRCUIT, CKT NO.

NOTES: PANEL IS EXISTING TO REMAIN. REMOVE FROM PANEL D WHILE IT IS REPLACED AND RECONNECT VIA 3 POLE BREAKER AS SHOWN ON PANEL SCHEDULE.

EXISTING PANEL N ELECTRICAL SCHEDULE. RATINGS: 208Y/120, 125 AMPS. LOCATION: PENTHOUSE. Includes table with columns: CKT NO, CIRCUIT, BREAKER, LOAD (KVA), BREAKER, CIRCUIT, CKT NO.

NOTES: 1- RELOCATED FROM CIRCUITS 22 & 24. 2- NEW BREAKER IN EXISTING PANEL.

LIGHTING POWER DENSITY SCHEDULE. Table with columns: NUMBER, NAME, SPACE TYPE, AREA, ALLOWED LPD, ACTUAL LPD.

LIGHTING FIXTURE SCHEDULE. Table with columns: TYPE, DESCRIPTION, MOUNTING, MANUFACTURER, MODEL NUMBER, LAMP, VOLT, VA, NOTE.

EQUIPMENT CONNECTION SCHEDULE. Table with columns: IDENTIFICATION, FLA/MCA, VOLTAGE/FH/L, LOAD, CKT. BKR, PANEL, CKT #, DISCONNECT, FEEDER SIZE, CONDUIT SIZE.

E

D


C

B

A

Altodesk Docs://CCAC-008\_Boyce\_Bio\_Lab/CCAC-008\_MEP\_24.rvt 5/13/2026 4:25:59 PM



- ONE-LINE DIAGRAM KEYNOTES**
- EXISTING CONDUIT SHALL BE REUSED TO THE EXTENT POSSIBLE. FEEDERS TO PANELS E AND D SHALL BE NEW.
  - BREAKER IS EXISTING TO REMAIN AND TO BE RE-USED.
  - BREAKER IS NEW AND TO BE INSTALLED IN EXISTING PANEL.
  - SEE EQUIPMENT CONNECTION SCHEDULE FOR MECHANICAL EQUIPMENT FEEDER AND DISCONNECT SIZES.
  - PANEL DD IS EXISTING TO REMAIN BUT A NEW FEEDER SHALL BE PULLED FROM PANEL D TO FEED IT.

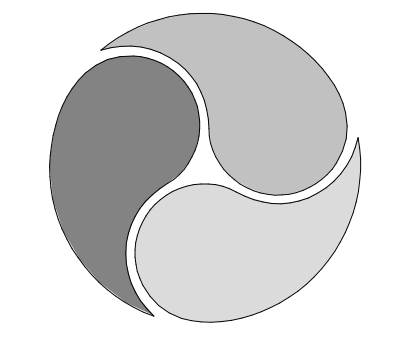

**AE WORKS**  
 418 BEAVER STREET  
 SEWICKLEY, PA 15143  
 PH: 412.287.7333  
 www.aeworks.com

CLIENT:  
**COMMUNITY COLLEGE  
 OF ALLEGHENY COUNTY**

- GENERAL NOTES**
- ETHERNET CABLES ARE BY INSTALLER
  - E-SWITCH IS INCLUDED. IF CCAC USES THEIRS, A DEDUCT WILL BE GIVEN
  - PRE-INSTALLATION MEETING IS REQUIRED PRIOR TO INSTALL
  - SENSORS IN EACH SPACE, WHERE REQUIRED, WILL ALLOW FOR SETBACK FOR HVAC - COORDINATED WITH PROGRAMMER AND JCI
  - GREENBUS IS SUPPLIED BY MANUFACTURER
  - ALL FIXTURES IN THE SPACE ARE NEW
  - FINAL DRAWINGS WILL BE SUBMITTED FOR APPROVAL

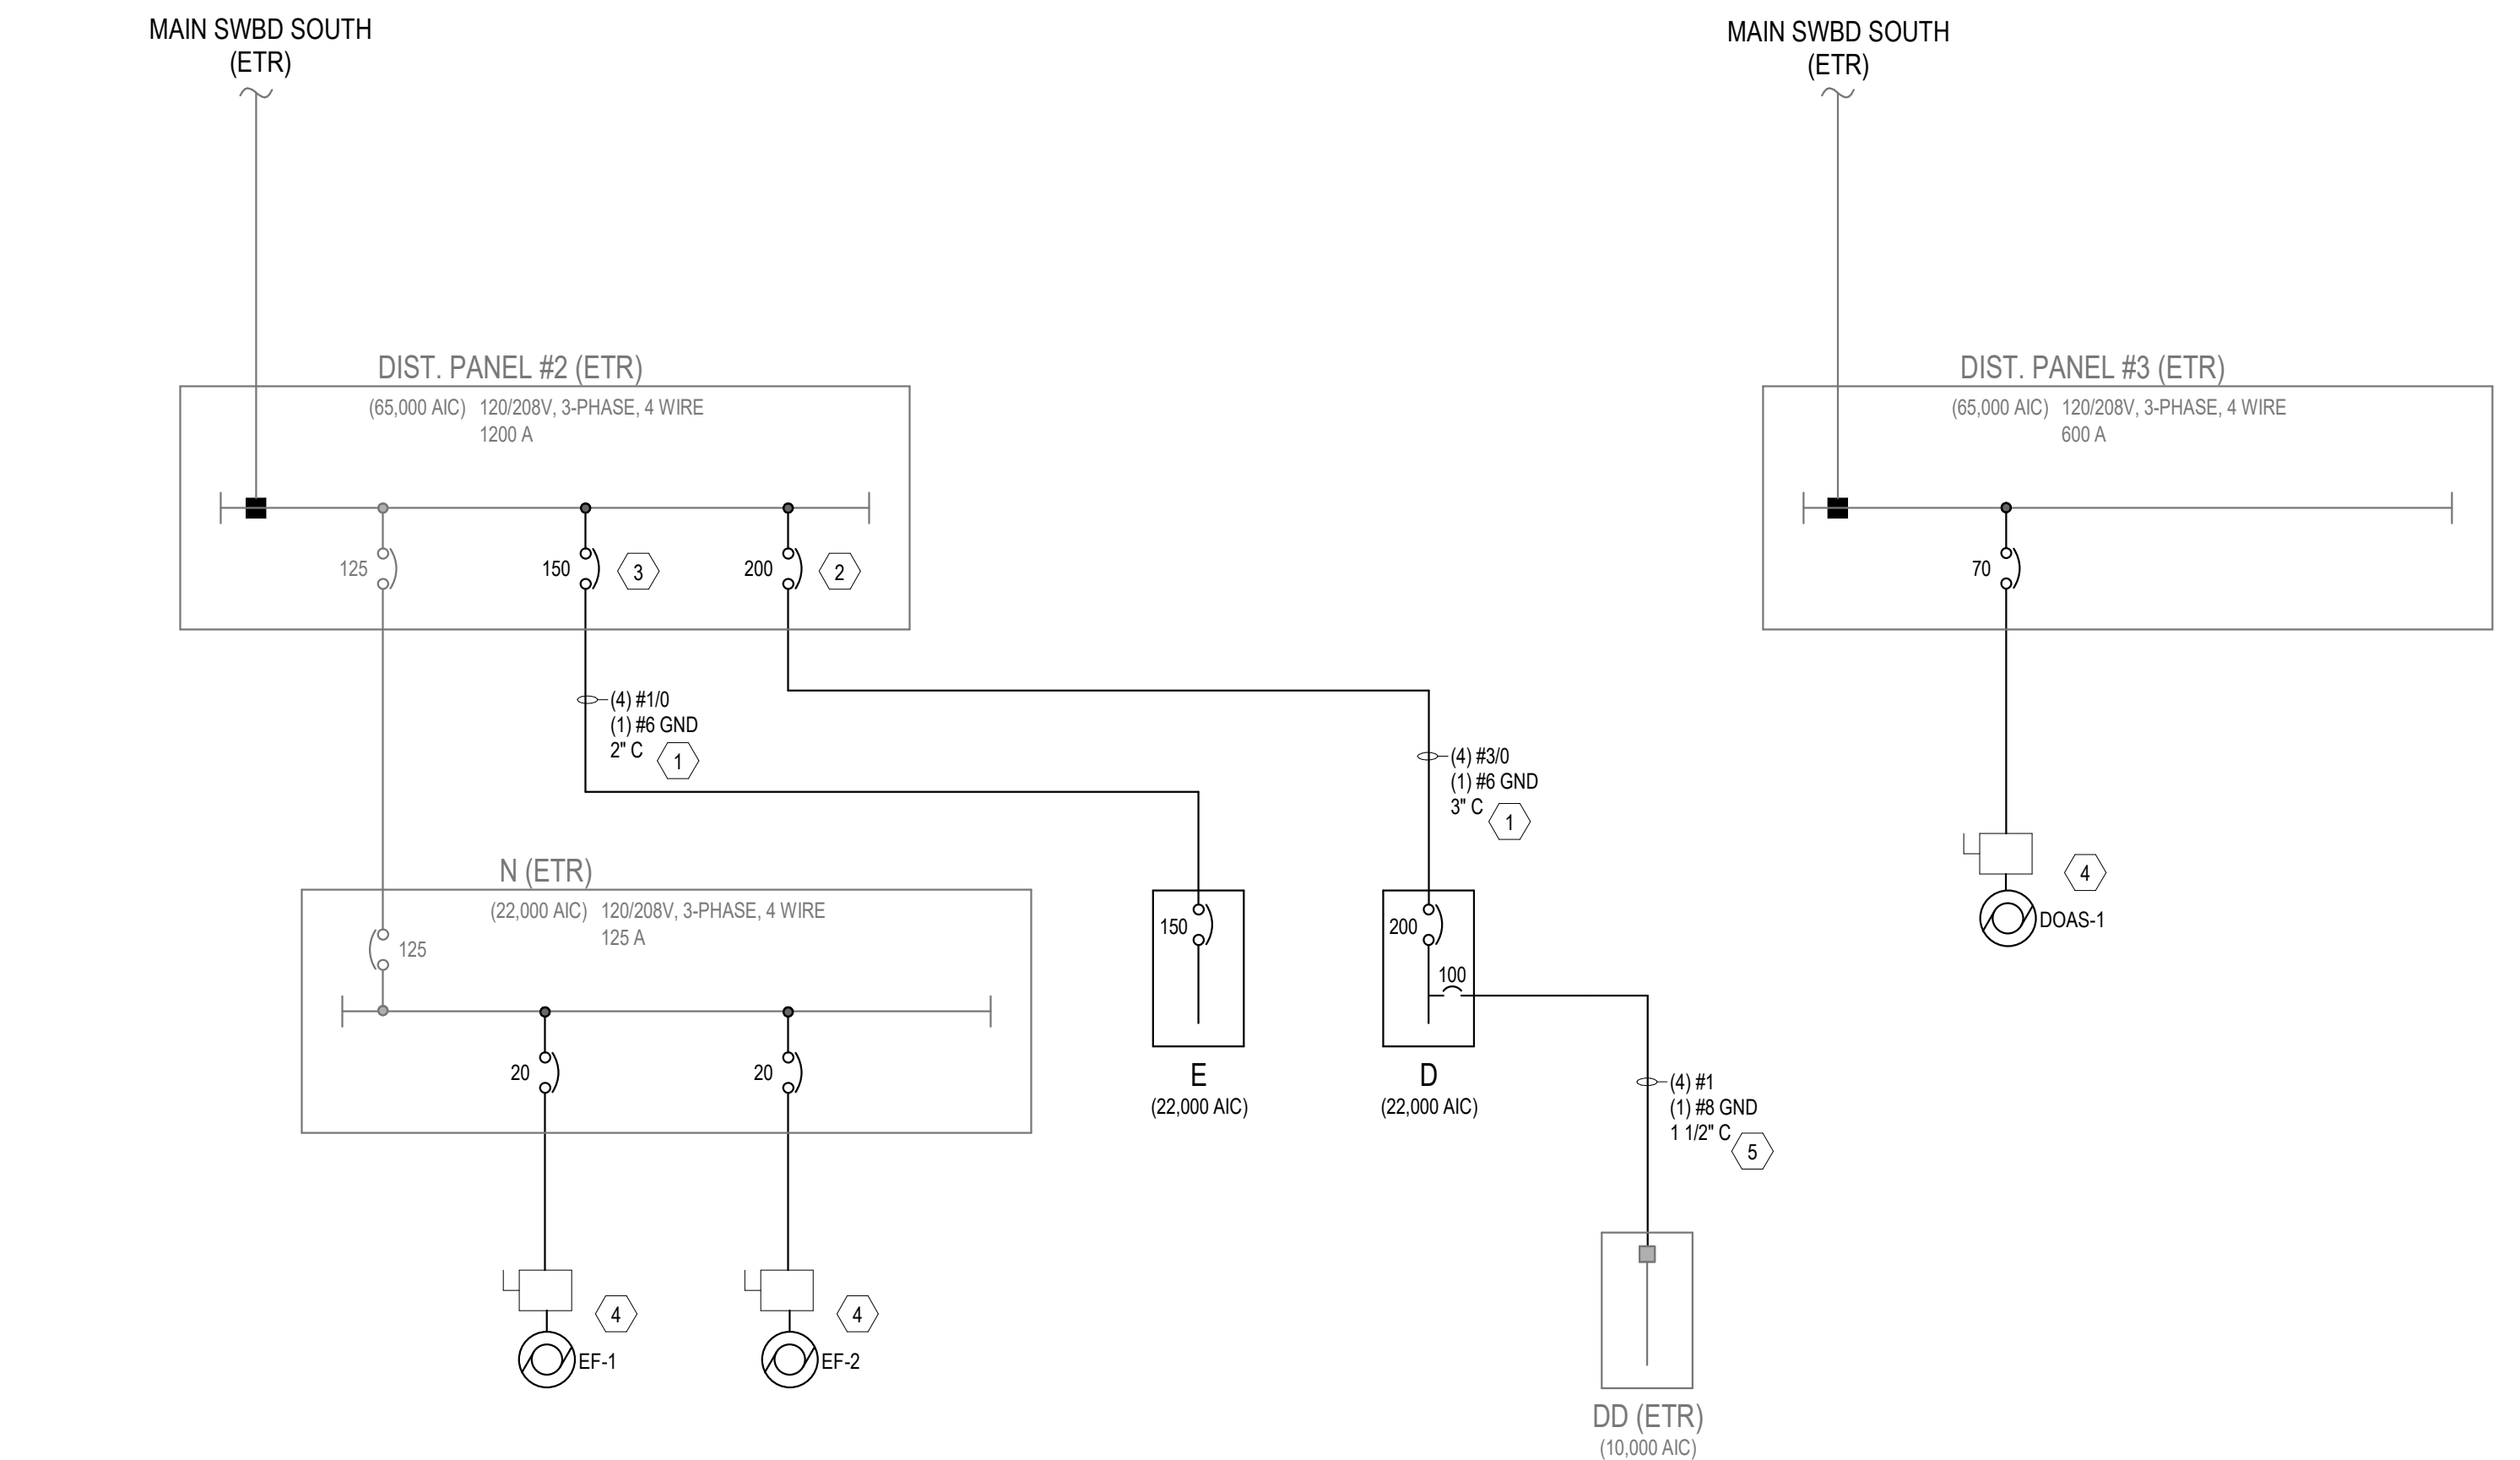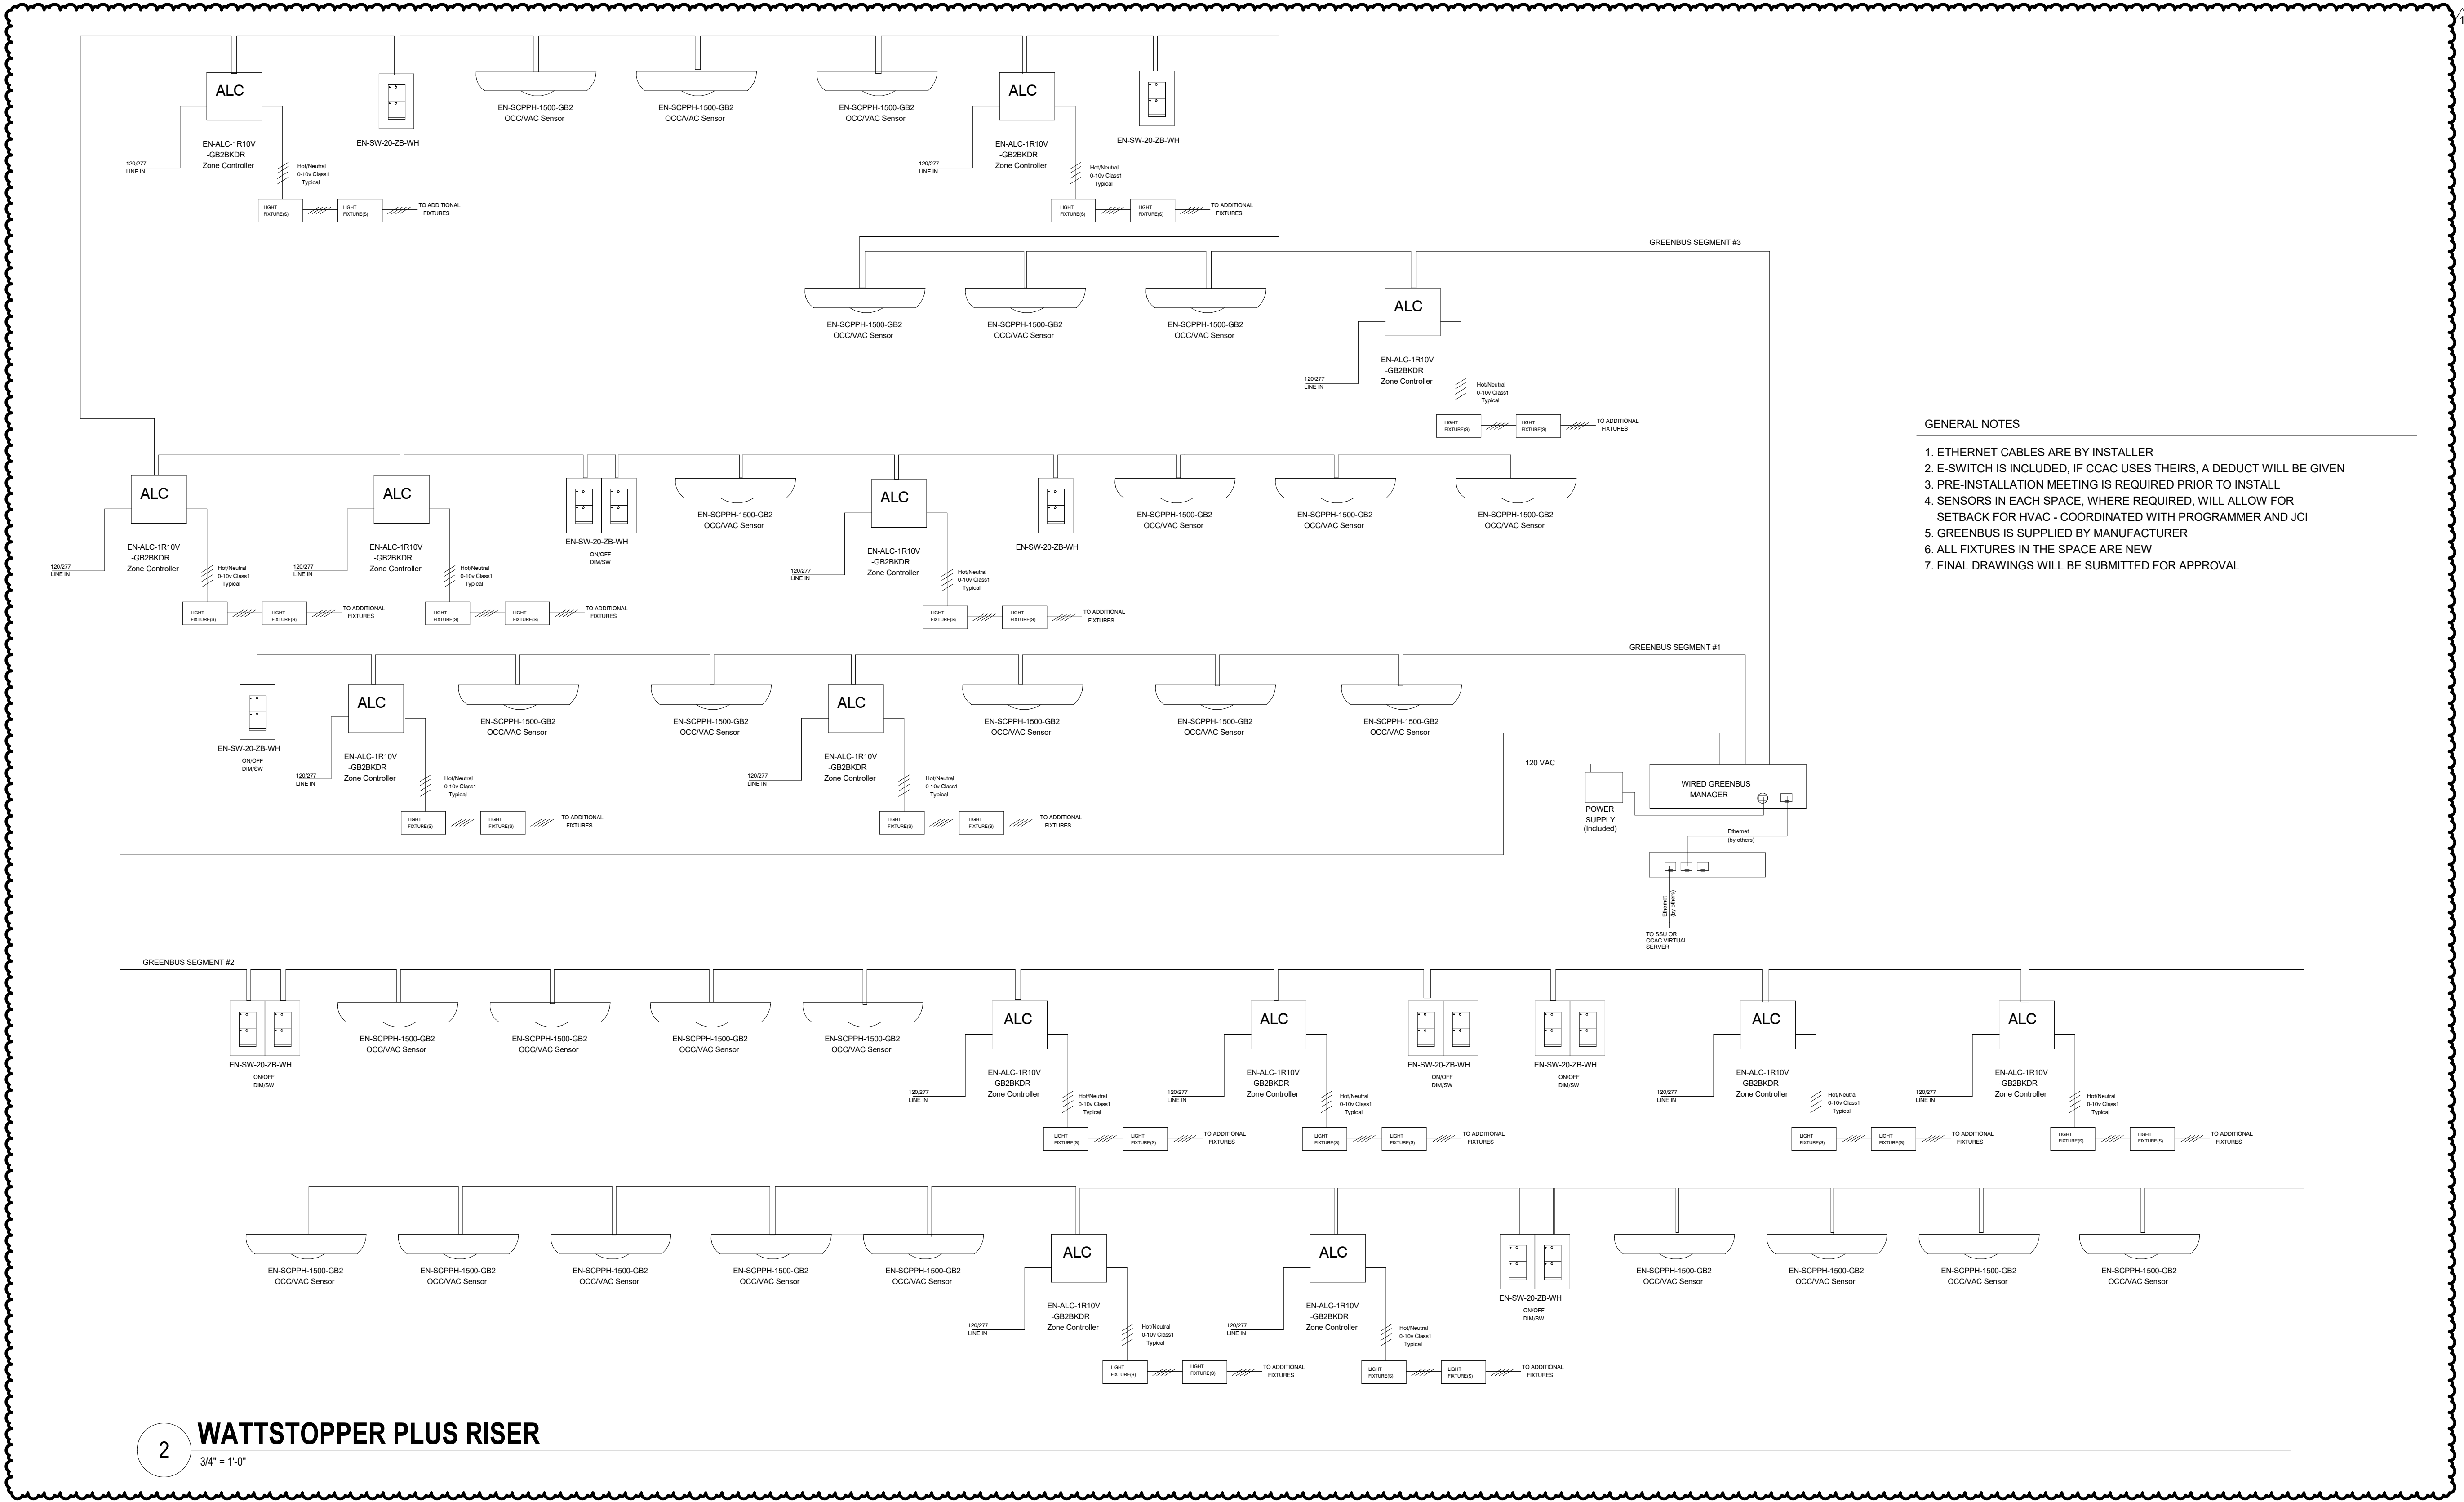

**1 PARTIAL ONE-LINE DIAGRAM**  
 NOT TO SCALE

595 Beatty Rd  
 Monroeville, PA 15146

SUBMISSION:  
**BID DOCUMENTS**

NO	DATE	REVISION
1	5/13/2026	ADDENDUM 3

PROFESSIONAL:

PROJECT NAME:  
**CCAC BIOLOGY LAB  
 RENOVATIONS BOYCE  
 CAMPUS**

595 Beatty RD, Monroeville PA  
 15146


DRAWING TITLE:  
**PARTIAL ONE-LINE  
 DIAGRAM**

DRAWN BY: JC  
 CHECKED BY: DF  
 PROJ. NO: CCAC-006  
 DATE: 04/14/2026  
 DRAWING NO:

**E602**

**FIRE ALARM PLAN GENERAL NOTES**

- 1 ALL FIRE ALARM WIRING & DEVICES SHALL BE IN ACCORDANCE WITH THE EXISTING FACILITY FIRE ALARM SYSTEM MANUFACTURER VENDOR'S POINT BY POINT WIRING DIAGRAM. THE FLOOR PLAN SHOWS THE PROPOSED QUANTITY OF FIRE ALARM SYSTEM COMPONENTS. CONTRACTOR SHALL PROVIDE ADDITIONAL DEVICES AND MODULES AS REQUIRED TO PROVIDE A FULLY FUNCTIONAL AND LOCAL/NATIONAL CODE COMPLIANT SYSTEM.
- 2 CONTRACTOR / VENDOR SHALL PREPARE PENNSYLVANIA LICENSED P.E. WORKING FIRE ALARM SYSTEM DRAWINGS INCORPORATING THE FIRE ALARM CRITERIA DESIGN AND CONFORMING TO AHJ REQUIREMENTS. CONTRACTOR SHALL PROVIDE ALL MATERIAL REQUIRED PER AHJ DESIGN CRITERIA FOR A FULLY FUNCTIONING FIRE ALARM SYSTEM. SUBMIT SIGNED AND SEALED DOCUMENTS TO THE DESIGN PROFESSIONAL AS A SHOP DRAWING FOR REVIEW.
- 3 THE INTENT IS FOR THE CONTRACTOR TO INSTALL ALL REQUIRED COMPONENTS FOR A FULLY FUNCTIONING FIRE ALARM SYSTEM AS AN EXTENSION TO THE EXISTING FIRE ALARM SYSTEM IN THE FACILITY.

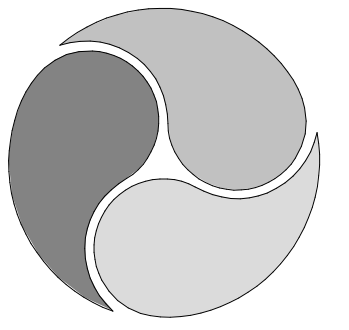

**AE WORKS**

418 BEAVER STREET  
SEWICKLEY, PA 15143  
PH: 412.287.7333  
www.aeworks.com

CLIENT:  
**COMMUNITY COLLEGE  
OF ALLEGHENY COUNTY**

595 Beatty Rd  
Monroeville, PA 15146

SUBMISSION:  
**BID DOCUMENTS**

NO	DATE	REVISION
1	5/13/2026	ADDENDUM 3

PROFESSIONAL:

PROJECT NAME:  
**CCAC BIOLOGY LAB  
RENOVATIONS BOYCE  
CAMPUS**

595 Beatty RD, Monroeville PA  
15146

DRAWING TITLE:  
**PARTIAL SIXTH FLOOR  
FIRE ALARM PLAN**

DRAWN BY: JC  
CHECKED BY: DF  
PROJ. NO: CCAC-006  
DATE: 04.14.2026  
DRAWING NO:

**FA101**

COPYRIGHT 2020 BY AE WORKS LTD ALL RIGHTS RESERVED.


E

D

C

B

A

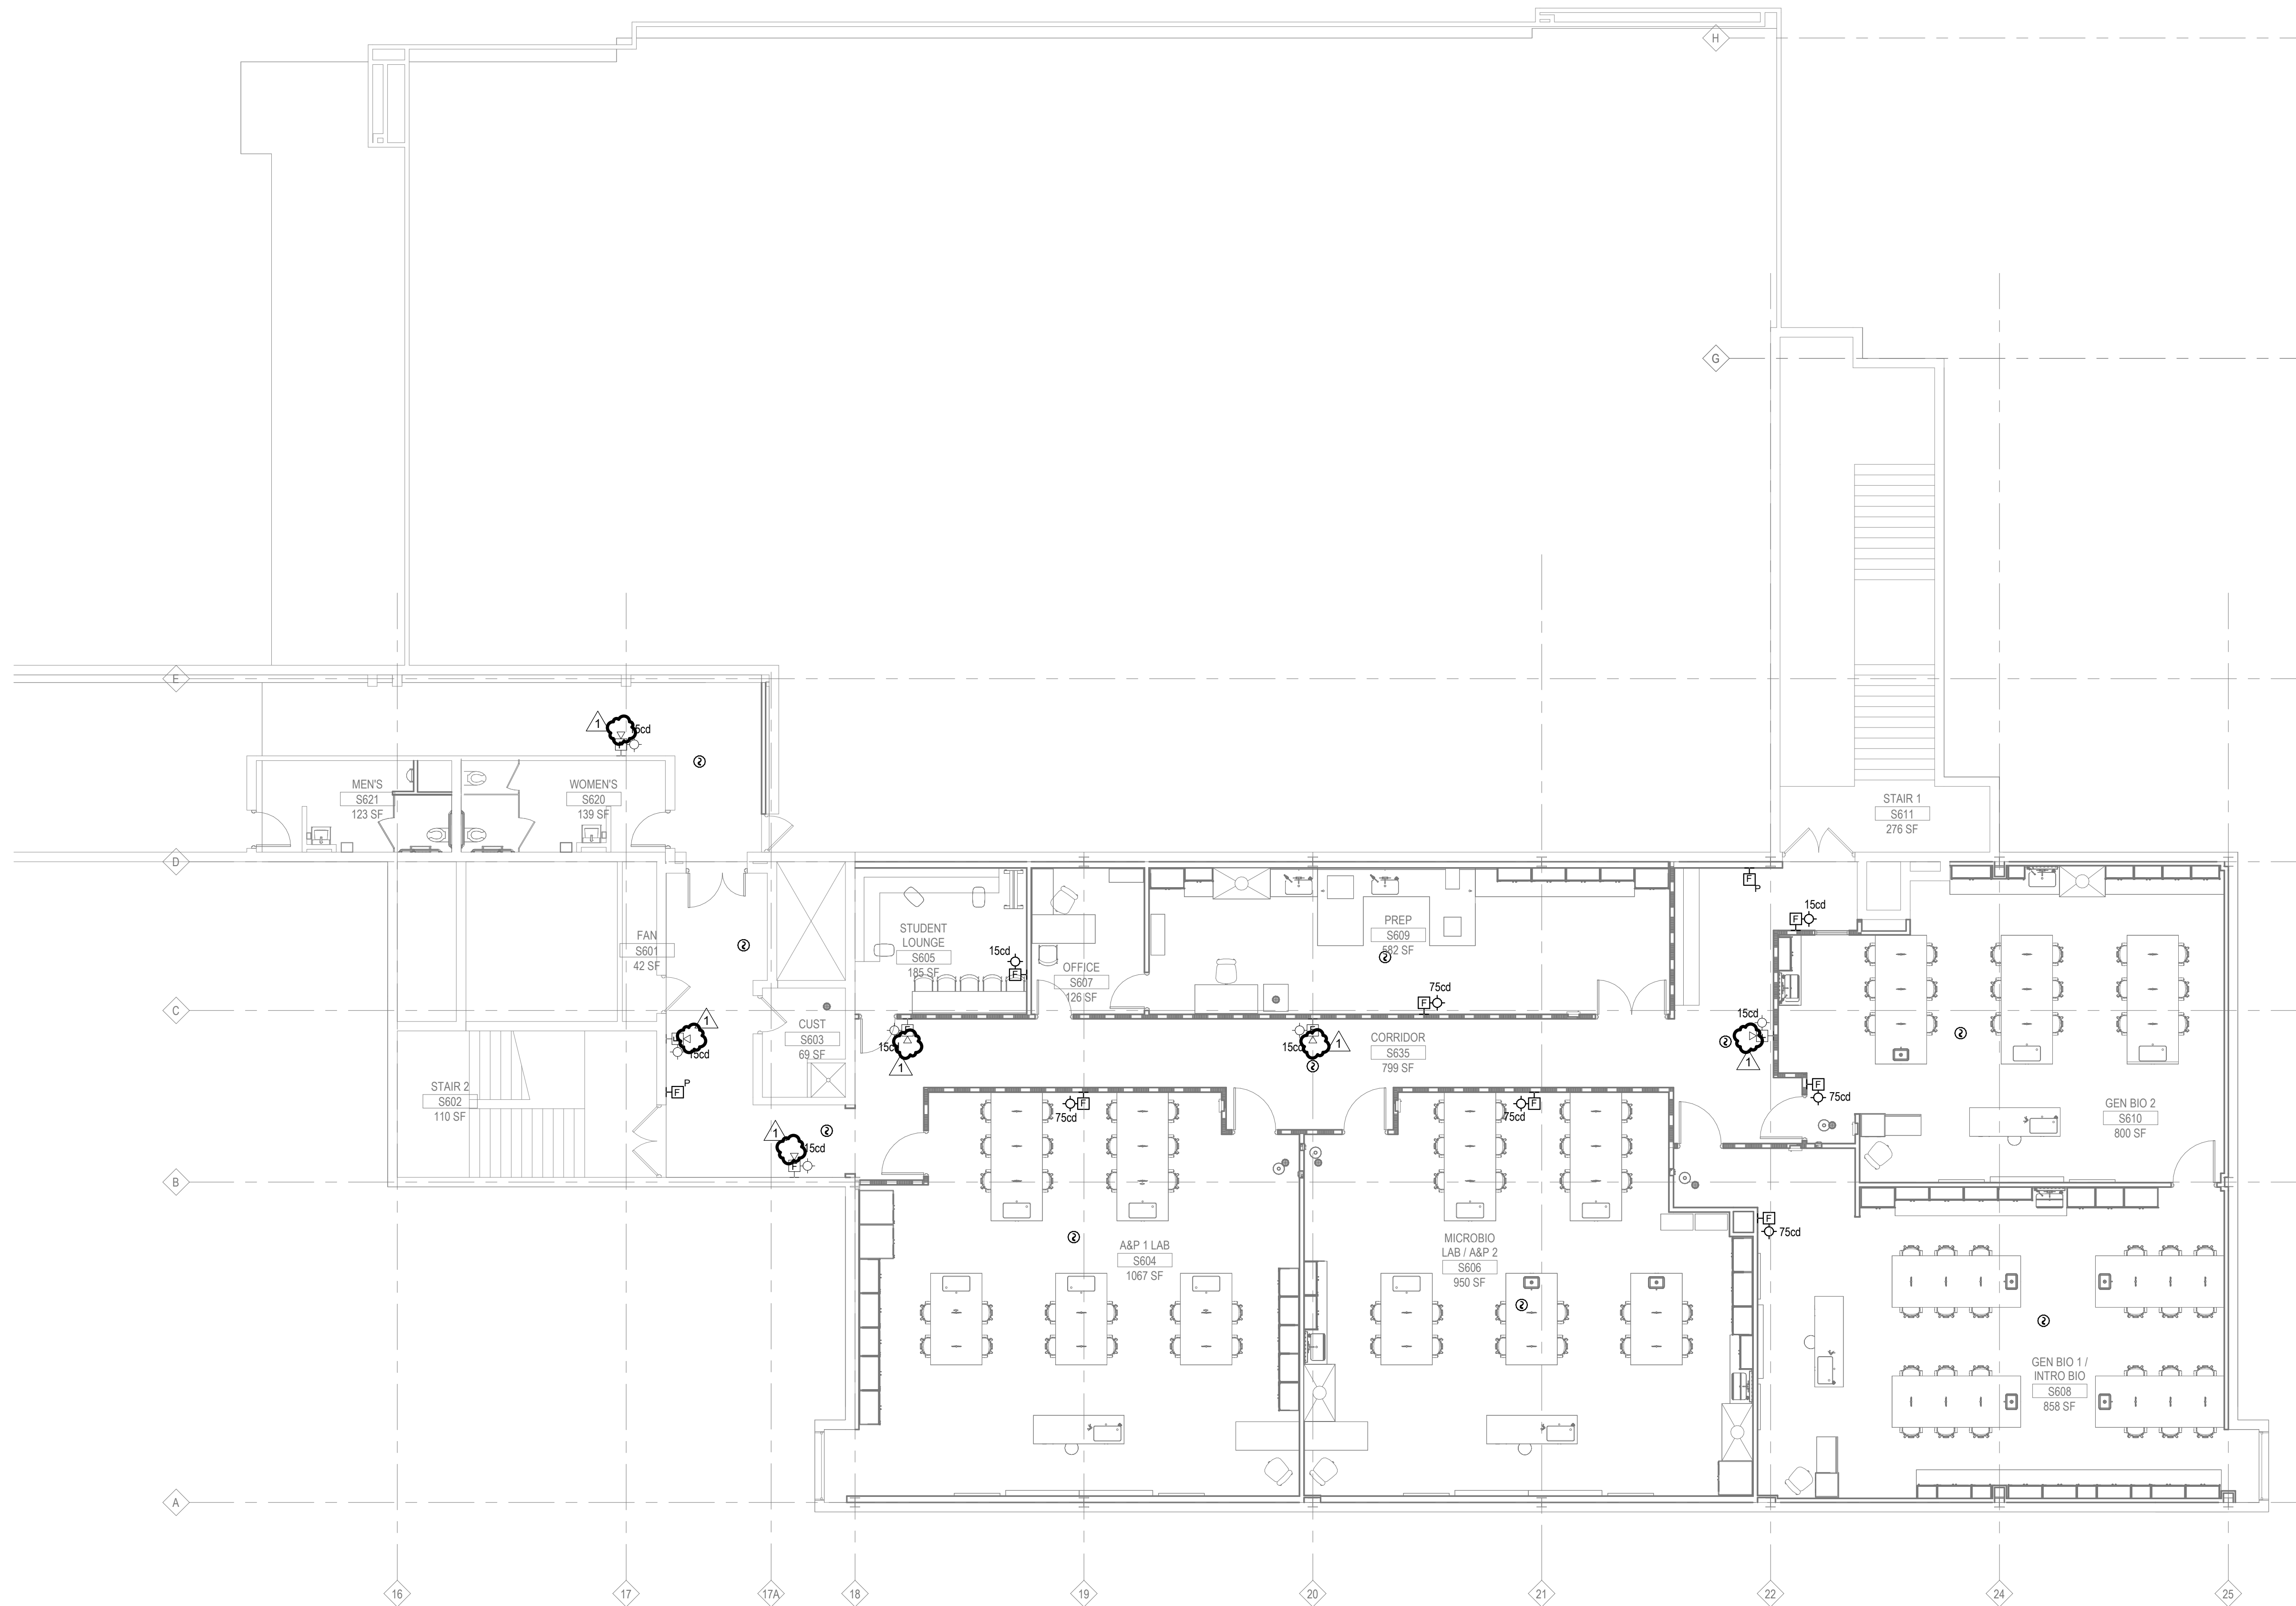

**1 PARTIAL SIXTH FLOOR FIRE ALARM PLAN**  
1/8" = 1'-0"

Altodesk Docs://CCAC-006\_Boyce\_Bio\_Lab/CCAC-006\_MEP\_24.rvt  
5/13/2026 4:24:11 PM

